


DATE 10/28/2020

TOWN OF LEXINGTON — BOARD OF PUBLIC WORKS
SEWER DIVISION

Sketch of Service Here

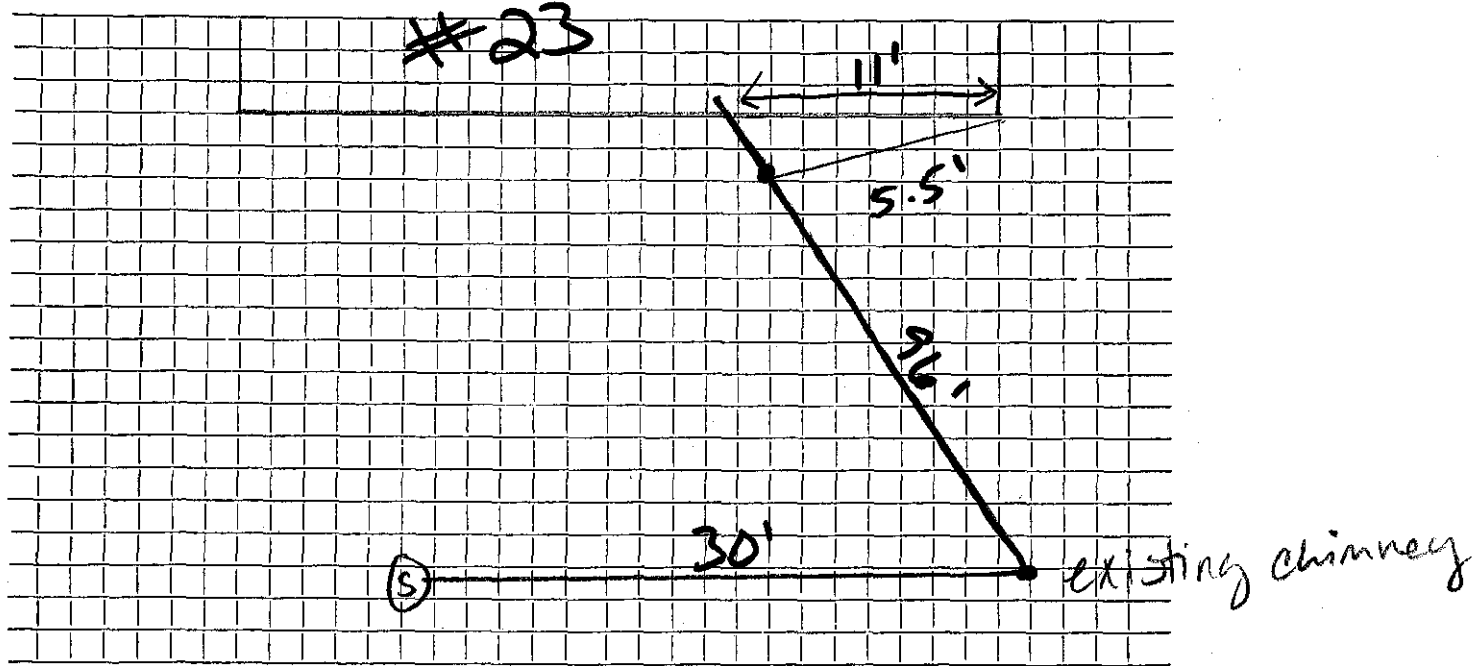

Connection made in Whipple Rd Street: Work completed

Remarks:
.....
.....