


TOWN OF LEXINGTON — BOARD OF PUBLIC WORKS

SEWER DIVISION

DATE _____

Sketch of Service Here

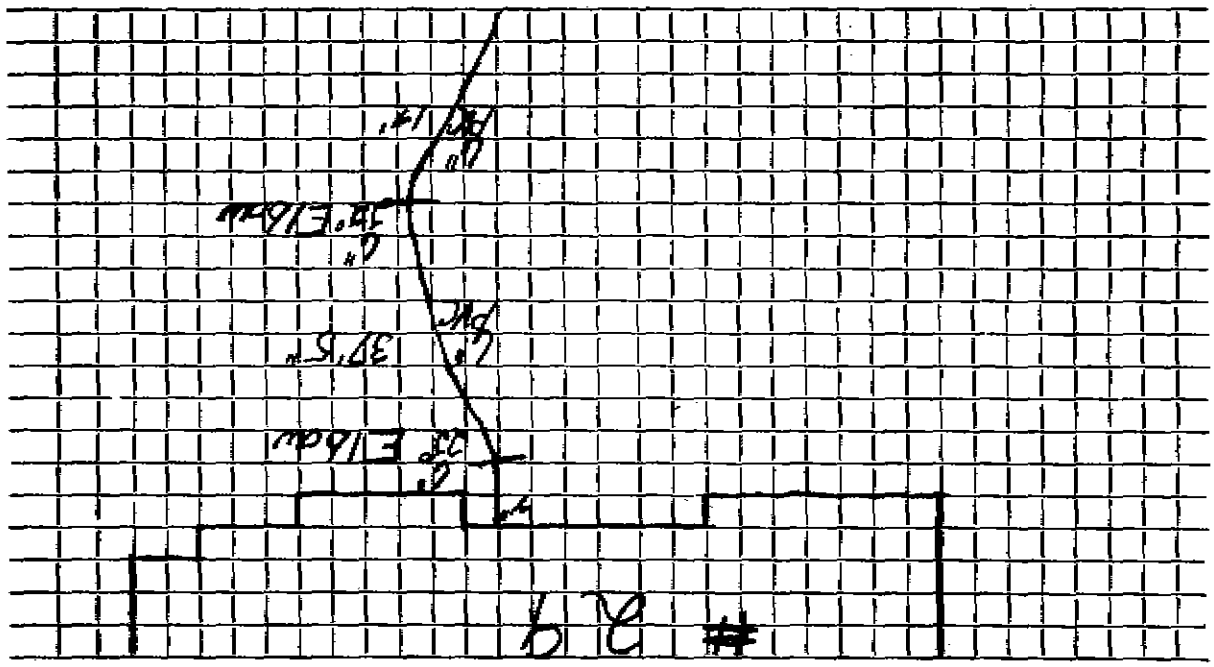

219

Connection made in Street.

Work completed

Remarks: WATER RIGGS NEXT TO CELL FROM WATER SHUT OFF TO STREET