

Name Mrs. Irwin Goldman

Service No. 52-53

Address 30 Whipple Road

30 Whipple Road

Location

Kind of Pipe

Size 6"

Size of Main 8"

~~Repair~~ Renewal ~~New Service~~


W.O. #2474

Location FEB 10 1975

Date	Material	Amount	Total	Date	Amount
12-74	Labor	22.88		8-13-74	Deposit 350.00
14-74	Labor	50.10	72.98	8-8-74	Deposit 100.00
	10 % O.H.	7.80	\$80.28		Retard 312.30
	37.5' 6" Transite Pipe @1.10		41.25	8-14-74	NON-CHARGE 137.98
1	1 1/2" EI		3.62	8-15-74	" 182.35
1	Donut		3.05	1	C.I. Saddle 6" X 8" 11.97
1	Hr. Trucking		3.00	1	1' x 6" Nipple 2.51
1	Hr. Town Shovel		6.50	1	90° el 5.63
			\$137.70	1/2	Bag Cement .55
				10	Bricks 40
				10'	6" Transite Pipe @1.10 19.80
				3	Ton Top @12.14 36.42
				8	Hrs. Town Shovel @6.50 52.00
				35	Hrs. Trucking @3.00 15.00
				2 1/2	Hrs. Pick up @1.50 3.75
				1	Hr. Compressor @5.00 5.00
					\$448.35

SEWER DIVISION

Sketch of Service Here
30

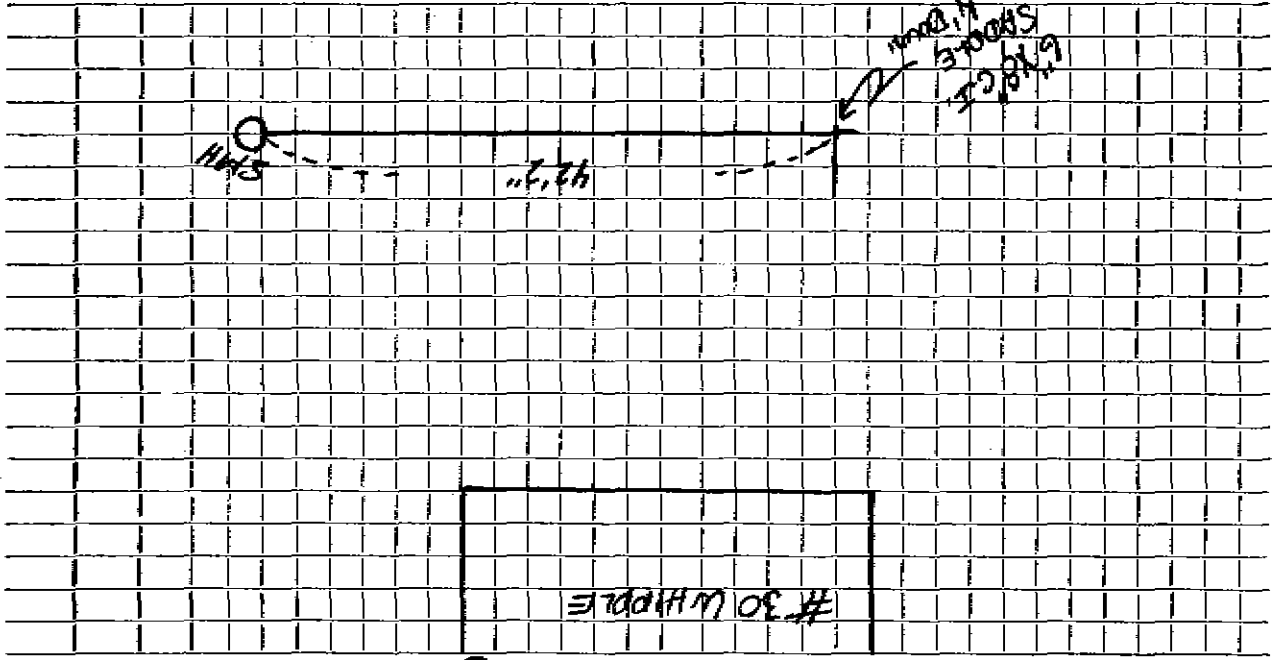

Connection made in _____ Street. Work completed _____

Remarks: _____