


DATE _____

TOWN OF LEXINGTON — BOARD OF PUBLIC WORKS

SEWER DIVISION

Sketch of Service Here

12

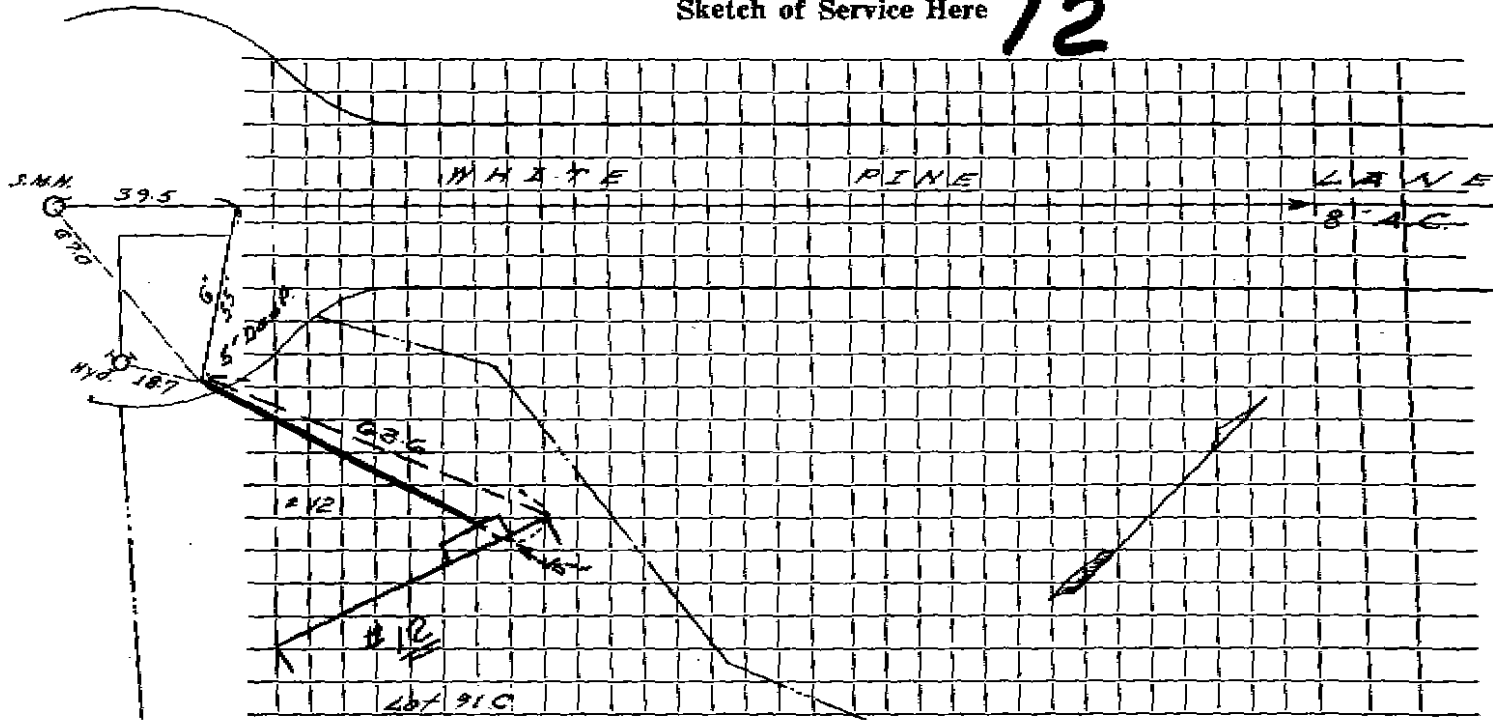

*Notes: Both House Numbers #14 & #12
 Will Be In Lot 91-C Until Future
 Subdivision*

Connection made in Street. Work completed

Remarks:

.....

.....