

Name

Service No.

Address

3 White Pine Lane

3 White Pine Lane

Location

Kind of Pipe

Size 6"

Size of Main 8"

Repair—Renewal—New Service

R.Stevens #823

Location

Date		Material	Amount	Total	Date	Amount
2-5-67	28'	6" Transite pipe				


DATE _____

TOWN OF LEXINGTON — BOARD OF PUBLIC WORKS

SEWER DIVISION

Sketch of Service Here

3

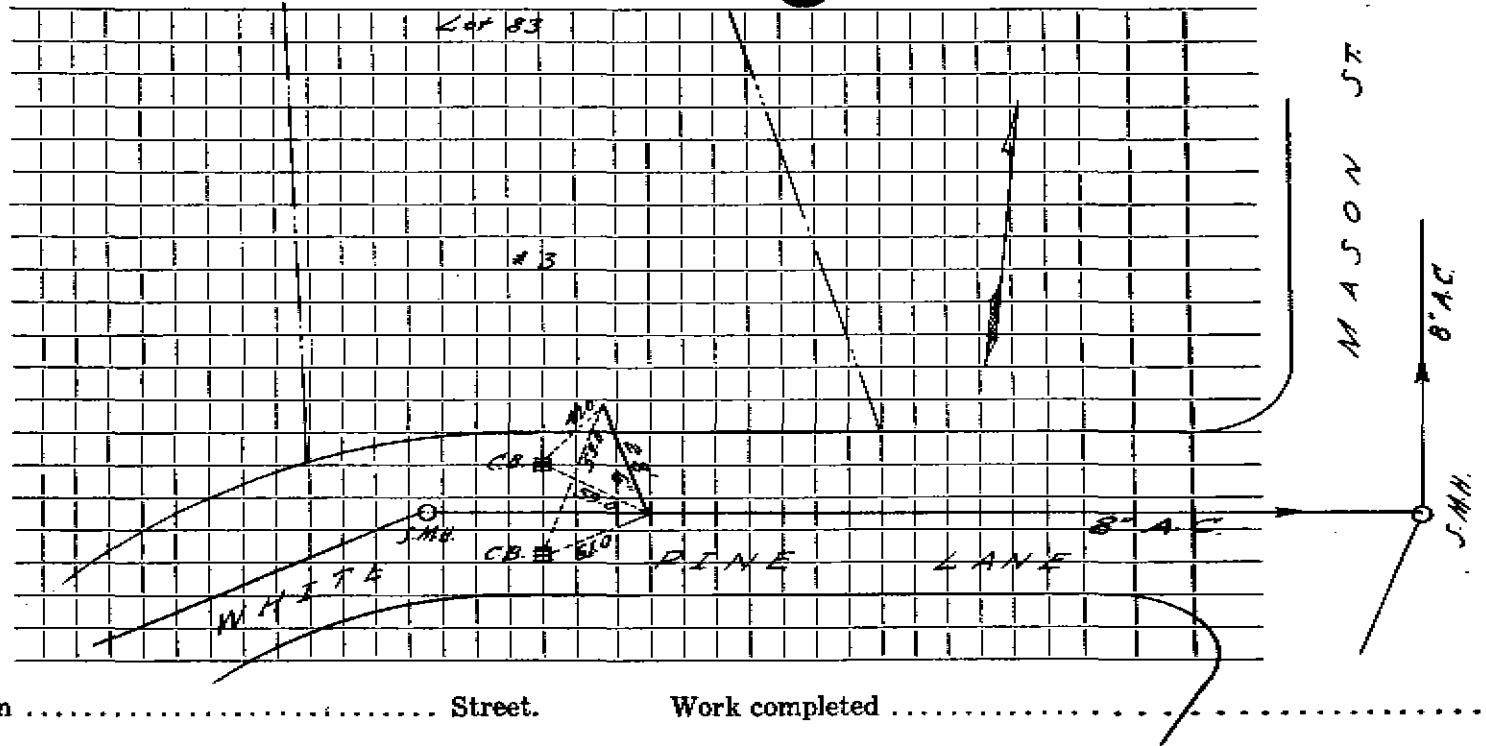

Connection made in Street. Work completed

Remarks:

.....

.....