
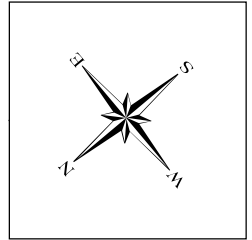


**Sewer Service Tie Card**  
**TOWN OF LEXINGTON**

**8 White Pine Lane**

MASSACHUSETTS

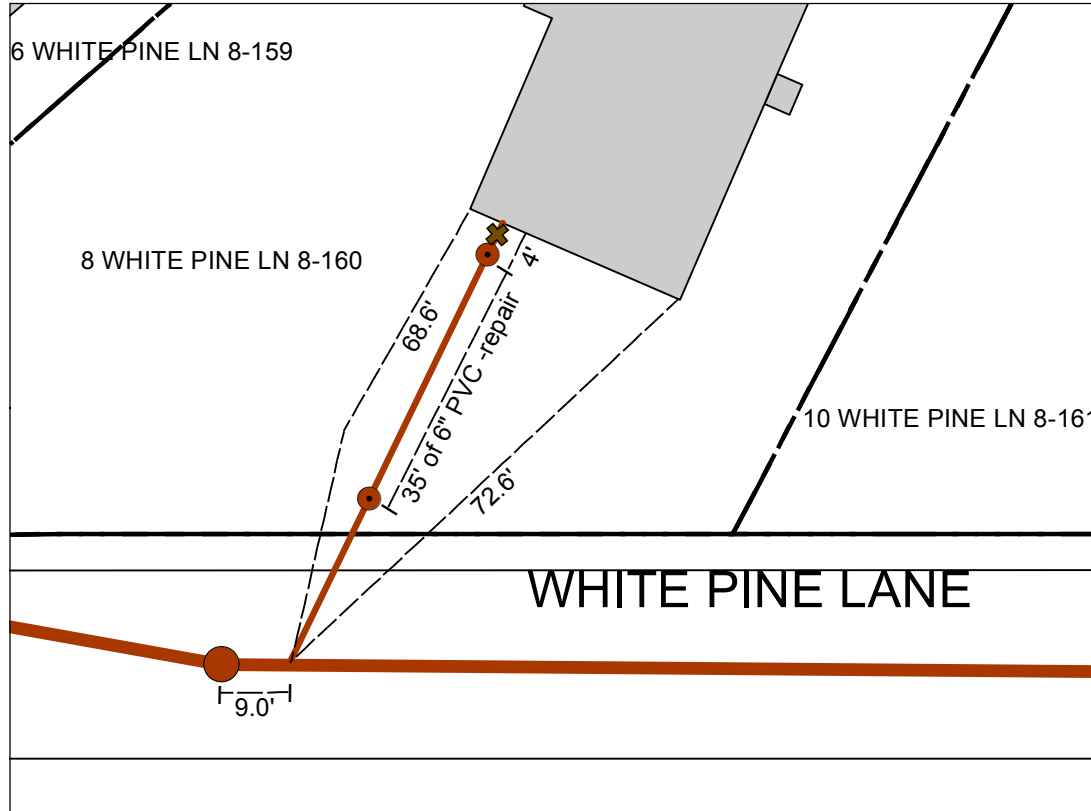

Legend	
<span style="color: brown;">●</span>	Sewer Manholes
<span style="color: brown;">+</span>	Sewer Service Clean Out
<span style="color: brown;">●</span>	Sewer Service Connection
- - -	Ties_Dimensions Sewer
<span style="color: brown;">—</span>	Sewer Service Line
<span style="color: brown;">—</span>	Sewer Main Line

Address	Map and Lot	Permit Number	Contractor Name	Inspector
8 White Pine Lane	8-160	5538	Santo	dpavlik

Date: 10/10/13	Material	Depth of Cover	Amount
	6x6 AC to PVC Fern Co	2.5 ft	Connect to existing stub
	6" PVC	3 ft	35 Feet to 4x6 Fern Co.

Type of work completed

**35 feet of new 6" PVC pipe installed to remove roots in joints of AC pipe.**