

Name **Ben Franklin Homes**

Service No. **12**

Address **2 White Terrace**

Lot #12 *Stg 0164*

Location

Kind of Pipe

Size **6"**

Size of Main **8"**

~~Basic Rate~~ **New Service** *WO# 7814*

Location *Owner 8-26-63*


Date	Material	Amount	Total	Date	Amount
10-1-62	Labor	27.50		4-2-63	Deposit 150.00
	10% O.H.	2.75	30.25	8-26-63	Paid by SHC#216 5.60
	30' 6" Transite pipe @.82		24.60		155.60
	1 11 ¹⁰ / ₄ " Transite Elbow		2.35		
	BILL WHEN CONNECTED		57.20		
	120' 6" Transite pipe @.82		98.40		
			155.60		

DATE _____

TOWN OF LEXINGTON — BOARD OF PUBLIC WORKS

SEWER DIVISION

Sketch of Service Here **2**

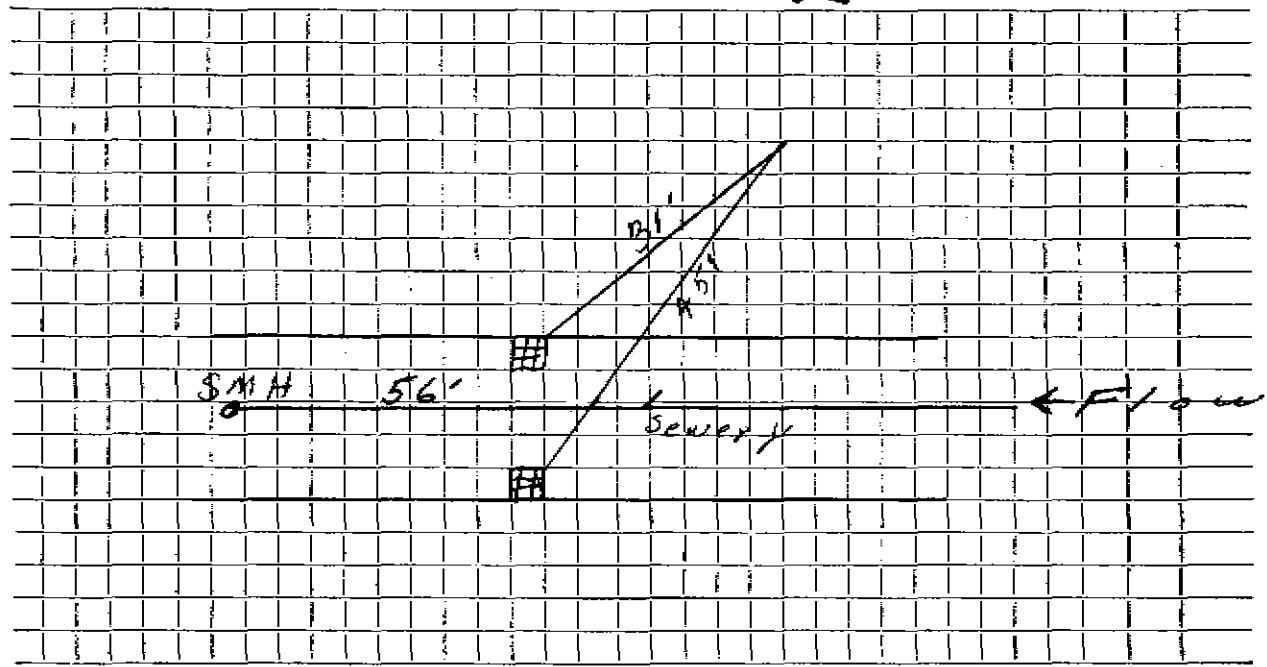

Connection made in Street. Work completed

Remarks:
.....
.....