

Name Benjamin Franklin Homes

Service No. 186

Address 4 White Terrace

Lot 13 Sta. 2+79

Location

Kind of Pipe

Size 6"

Size of Main 8"

Repair—Renewal—New Service NO #7720

Location Comm 1-14-63

Date	Material	Amount	Total	Date	Amount
10-2-62	Labor	30.20		11-8-62	Deposit 300.00
	10% O.H.	3.02	33.22	1-14-63	Refund 49.50
	20' 6" Transite pipe @.82		16.40		250.50
	1 11 $\frac{1}{2}$ " Transite Elbow		2.35		
	1 hr. Trucking @3.00		3.00		
	BILL WHEN CONNECTED		54.97		
11-15-62	Labor 19.79				
11-16-62	" 69.70	89.49			
	10% O.H.	8.95	98.44		
	65' 6" Transite pipe @.82		53.30		
	1 11 $\frac{1}{2}$ " Transite Elbow		2.35		
	1 22 $\frac{1}{2}$ " Transite Elbow		2.35		
	1 22 $\frac{1}{2}$ " Transite Bend		4.09		
	4 hrs. Town Shovel @6.50		26.00		
	3 hrs. Trucking @3.00		9.00		
			250.50		


DATE _____

TOWN OF LEXINGTON — BOARD OF PUBLIC WORKS

SEWER DIVISION

Sketch of Service Here

4

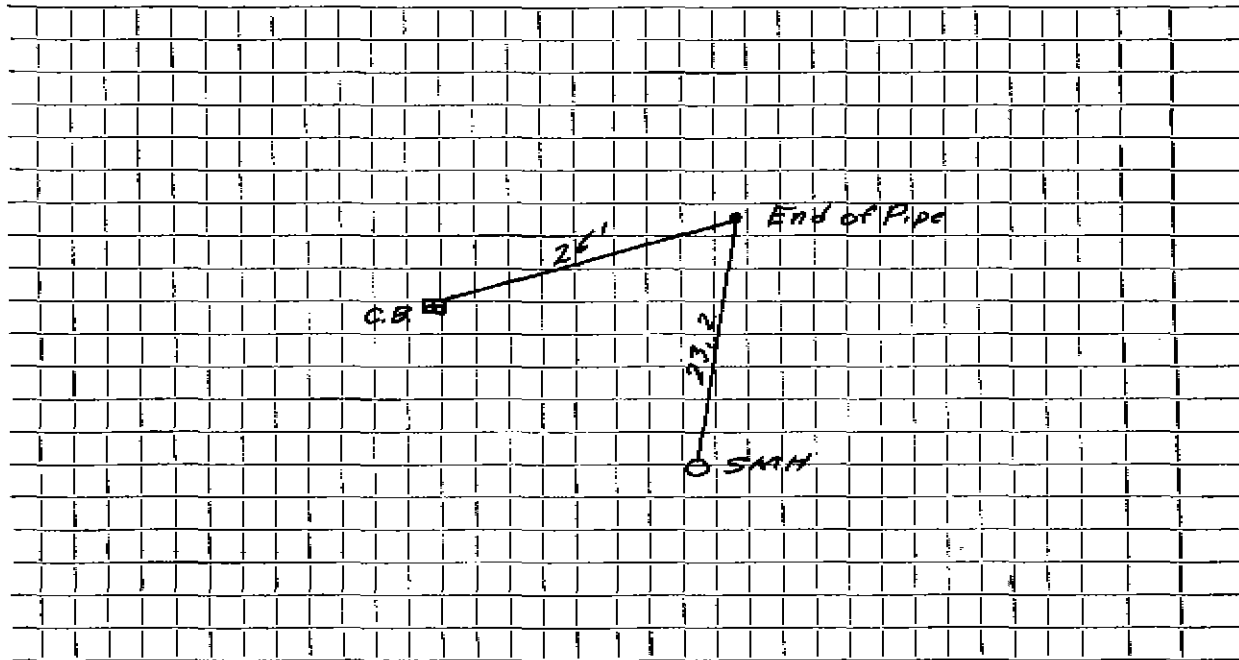

Connection made in Street. Work completed

Remarks: ... *Connection Made in Sewer Manhole Tie e curb Same as water*