

Name Benjamin Franklin Homes

Service No. 217

Address 5 White Terrace

Mr. N. N. STANSON

Lot 15 Sta. 3473

Location

Kind of Pipe

Size 6"

Size of Main 8"

~~REPLACEMENT~~ New Service

W att 2760

Location

Canon 4-22-63

Date		Material	Amount	Total	Date		Amount
0-2-62	L	Labor	35.97		12-6-62	Deposit	200.00
		10% O.H.	3.60	39.57	4-22-63	Paid by W.H.C.# 175	40.62
	60'	6" Transite pipe @.82		49.20	4-28-63	Cash	12.90
	1	11 1/2° Transite Bend		4.09			233.52
	1	hr. Trucking @3.00		3.00			
		BILL WHEN CONNECTED		95.86			
2-27-63		Labor	71.46				
		10% O.H.	7.15	78.61			
	39'	6" Transite pipe @.82		31.98	12-5-77	Release Solids	
	1	11 1/2° Transite Elbow		2.35	12/3/78	Solids	
	1	6" Duplex Adapter		1.62	6/13/70	S.B. (solids)	
	16	ton Bank Gravel		17.60	6/10/70	Solids.	
	2	hrs. Trucking @3.00		6.00	3/12/69	Solids	
	3	hrs. Town Shovel @6.50		19.50	10-14-66	PAPER DETERGENTS	
				253.52	11-12-65	SOB AT MANHOLE	
					8-14-73	sewer Block	


DATE _____

TOWN OF LEXINGTON — BOARD OF PUBLIC WORKS

SEWER DIVISION

Sketch of Service Here

LOT 15 5

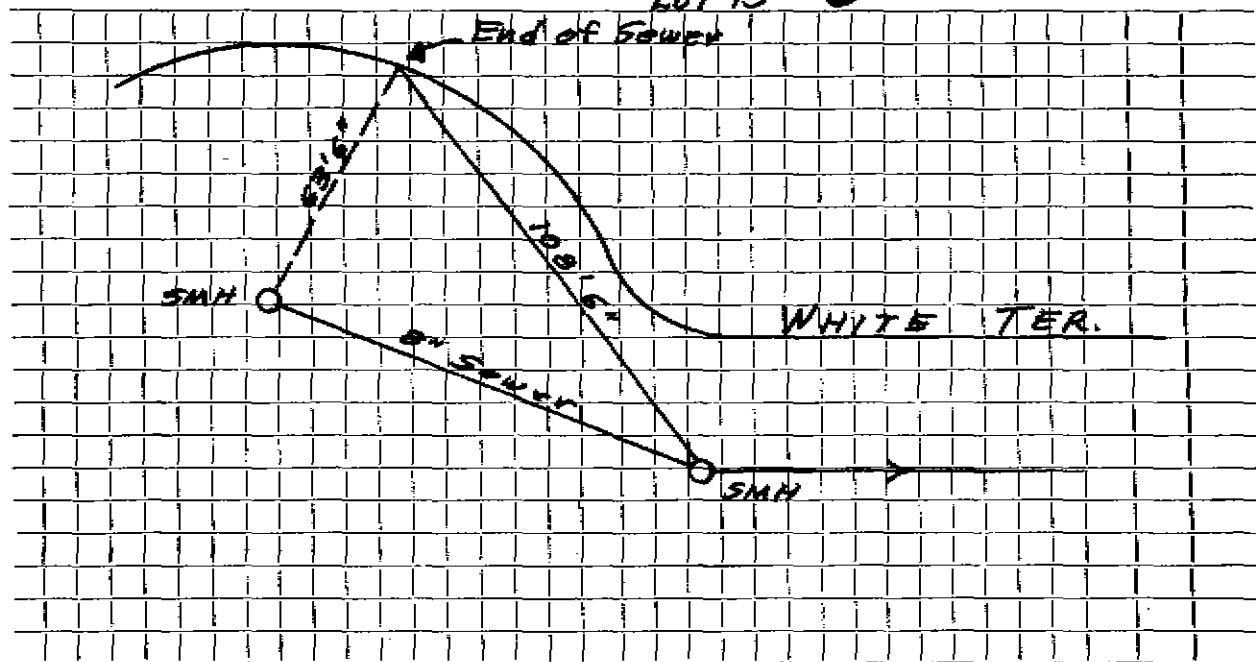

Connection made in Street. Work completed

Remarks:
.....
.....