

Name Benjamin Franklin Homes

Service No. 151

Address 7 White Terrace

Lot #14 Sta 4+24

Location

Kind of Pipe

Size 6"

Size of Main 8"

Repair—Renewal—New Service

WG # 7636

Location

Comm 12-10-62

Date	Material	Amount	Total	Date	Amount	
10-3-62	Labor	70.61		8-12-62	Deposit	125.00
	10% O.H.	7.06	77.67	12-10-62	Paid by WIT #128	2.92
117	6" Transite pipe @82		95.94	12-21-62		48.69
1	Hr. Trucking @3.00	3.00	3.00			176.61
			176.61			


DATE _____

TOWN OF LEXINGTON — BOARD OF PUBLIC WORKS

SEWER DIVISION

Sketch of Service Here

7

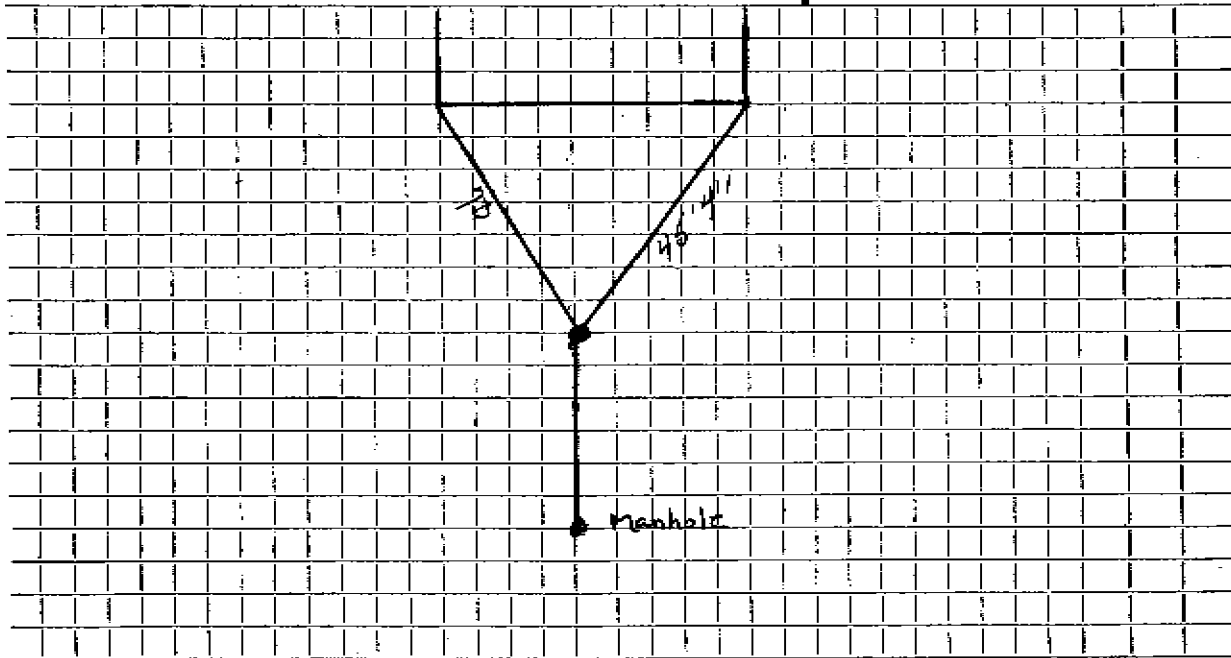

Connection made in Sewer .. connected on .. manhole Street. Work completed

Remarks: