

Name August H. Schutte

Service No. 18

Address 2 Whitman Circle

2 Whitman Circle

Location

Kind of Pipe

Size 6"

Size of Main 8"

Repair—Renewal—New Service

Bonanno #1840

Location JUL 2 6 1971


Date	Material	Amount	Total	Date	Amount
8-27-69	29' 6" Transite pipe	69.00	261.00	4-20-71	Deposit
4/23/71	96' 6" Transite pipe				

DATE _____

TOWN OF LEXINGTON — BOARD OF PUBLIC WORKS

SEWER DIVISION

Sketch of Service Here **2**
Lot 41A

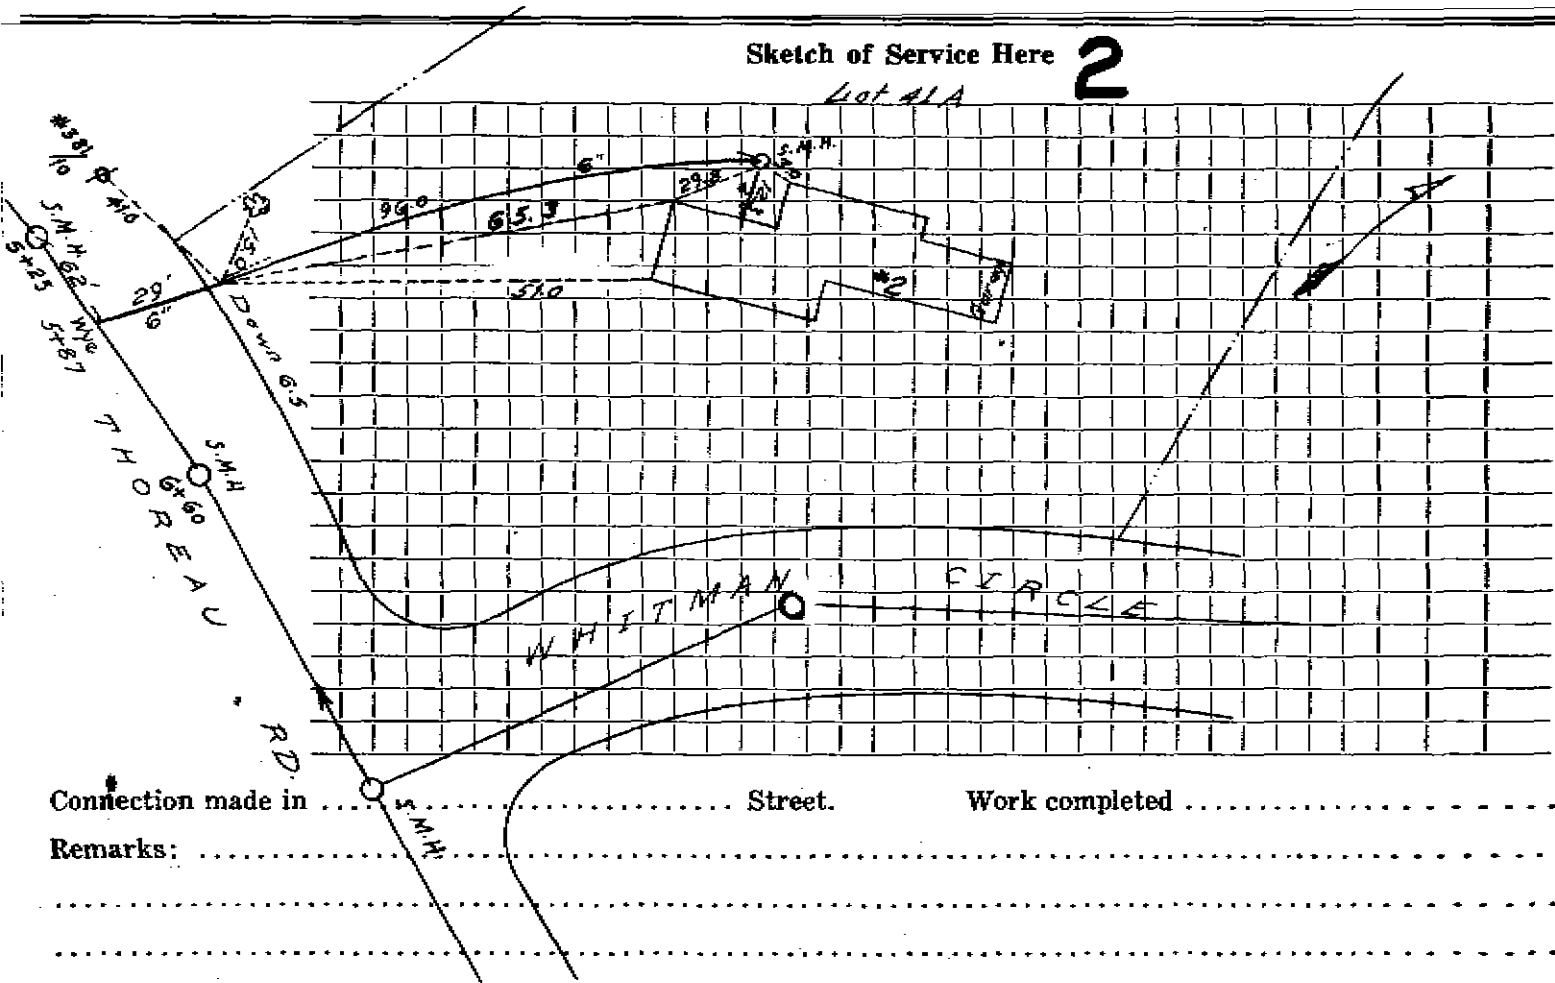

Connection made in Street. Work completed

Remarks:

.....

.....