

Name Tingley Construction

Service No.

Address 11 Whitter Road

11 Whittier Road

Location

Kind of Pipe

Size 6"

Size of Main 8"

~~Renewal~~ New Service

John E. Grant - Permit #62


Location

Date	Material	Amount	Total	Date	Amount
7-13-64	66' 6" Transite pipe				

DATE _____

TOWN OF LEXINGTON — BOARD OF PUBLIC WORKS
SEWER DIVISION

Sketch of Service Here //

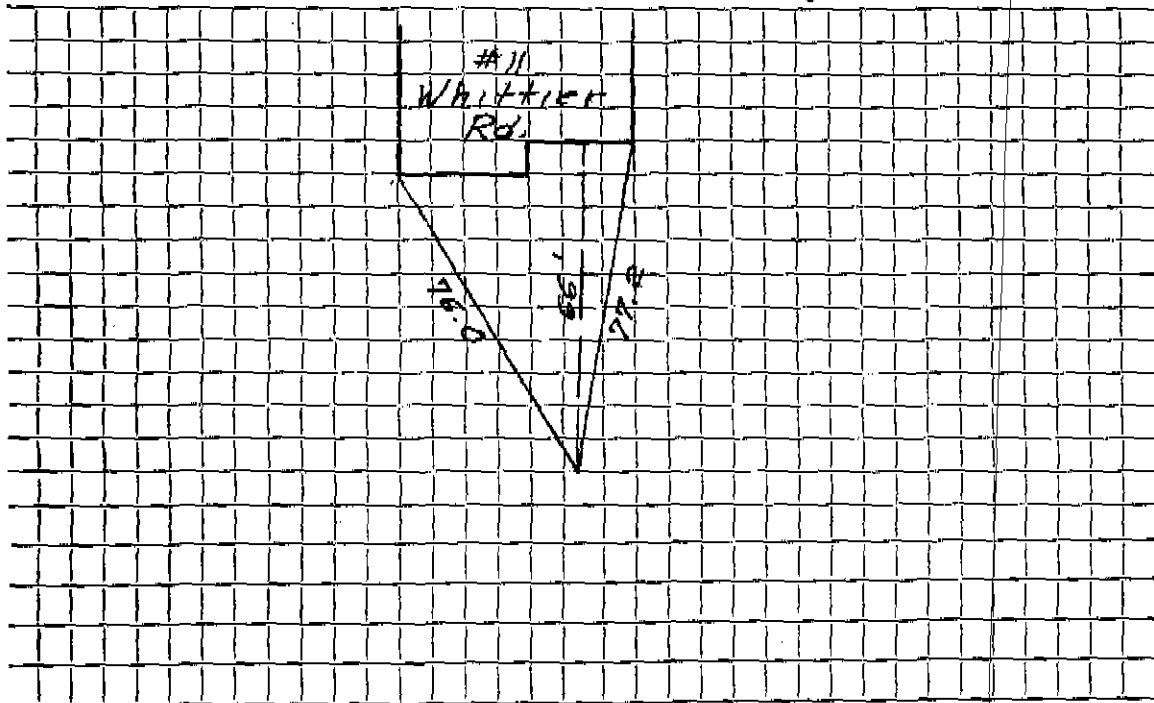

Connection made in Street. Work completed

Remarks:

.....