

Name Tingley Construction

Service No.

Address 15 Whitter Road

15 Whittier Road

Location

Kind of Pipe

Size 6"

Size of Main 8"

~~Repair~~ New Service John E. Grant - Permit #43

Location

Date Material Amount Total Date Amount


7-13-64 65' 6" Transite pipe

DATE _____

TOWN OF LEXINGTON — BOARD OF PUBLIC WORKS
SEWER DIVISION

Sketch of Service Here

15

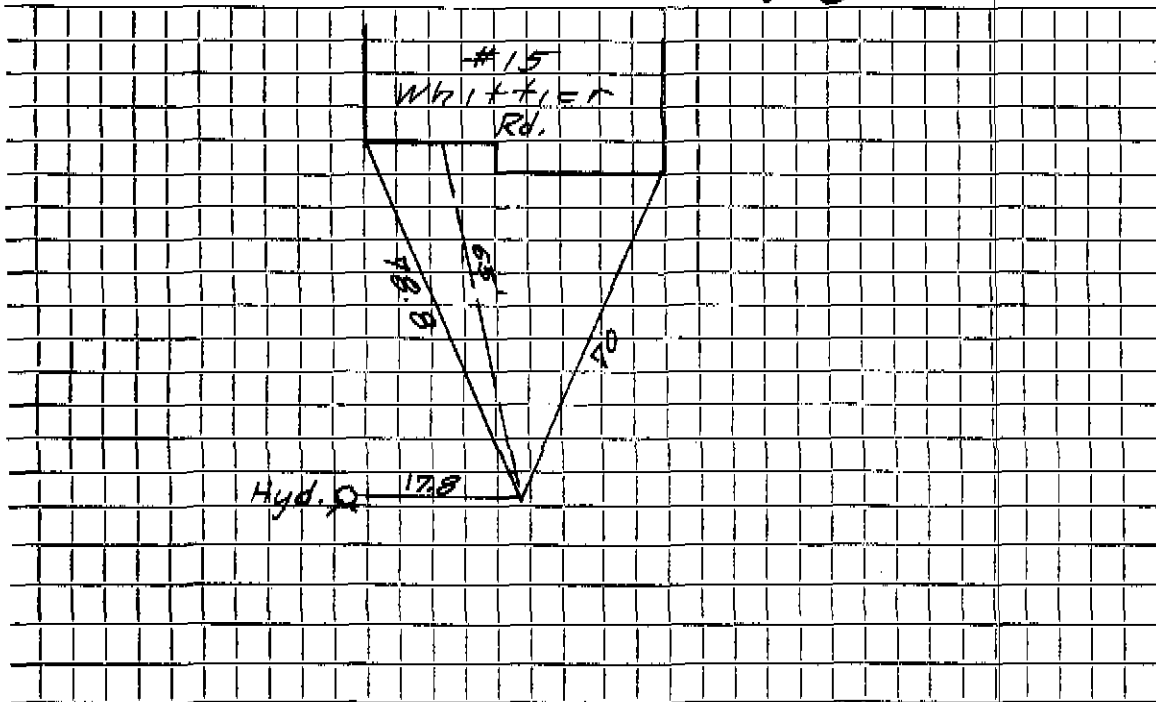

Connection made in Street. Work completed

Remarks:

.....