

Name Tingley Construction Co. Inc.

Service No.

Address 17 Whittier Road

17 Whittier Road

Location

Kind of Pipe

Size 6"

Size of Main 8"

~~Material~~ New Service Lucente Permit #106


Location

Date	Material	Amount	Total	Date	Amount
1964	72' 6" Transite pipe				

DATE \_\_\_\_\_

TOWN OF LEXINGTON — BOARD OF PUBLIC WORKS  
SEWER DIVISION

Sketch of Service Here **17**

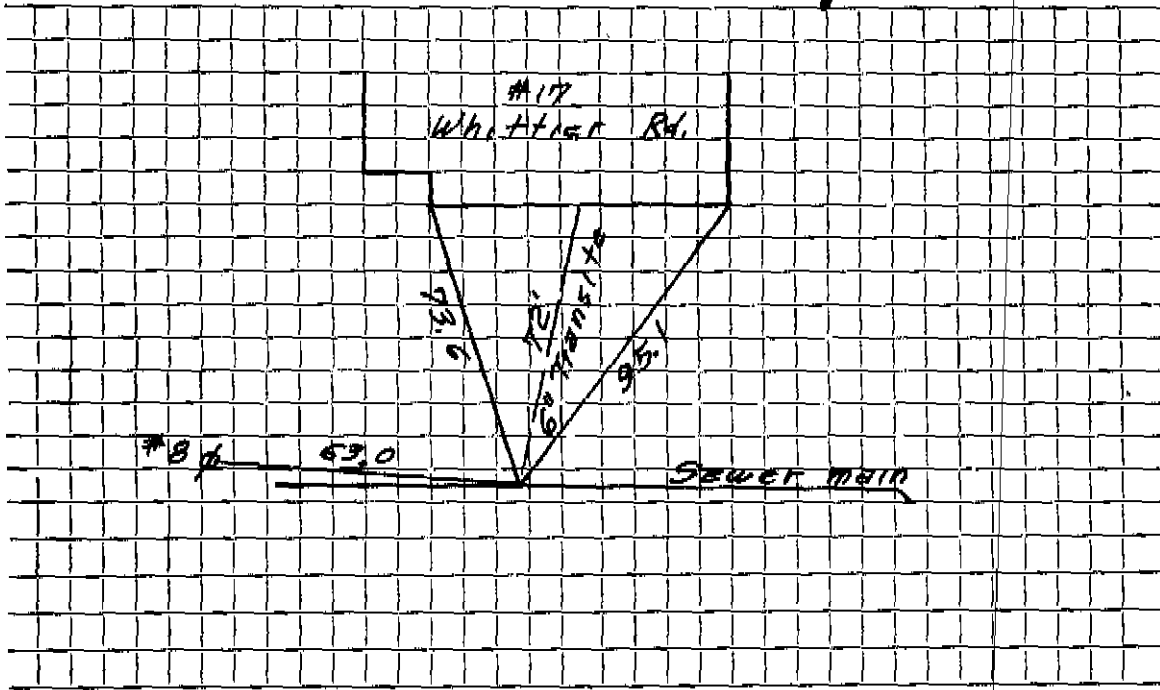

Connection made in ..... Street. Work completed .....

Remarks: .....

.....

.....