

Name

Service No.

Address 2 WHITTIER RD.

2 Whittier Road

Location

Kind of Pipe

PVC

Size

6" PVC

Size of Main

8 3/4

Repair—Removal ~~(New Service)~~

S.M. McLAUGHLIN

PERMIT # 0679

Location N.B. St. SW 95-2

Date

Material

Amount

Total

Date

Amount

AUG 95

126'± 6" PVC

2 - CLEAN OUTS

2 - 45° ELBOWS

1 - FERNCO


DATE AUG. '95

TOWN OF LEXINGTON — BOARD OF PUBLIC WORKS

SEWER DIVISION

Sketch of Service Here

2

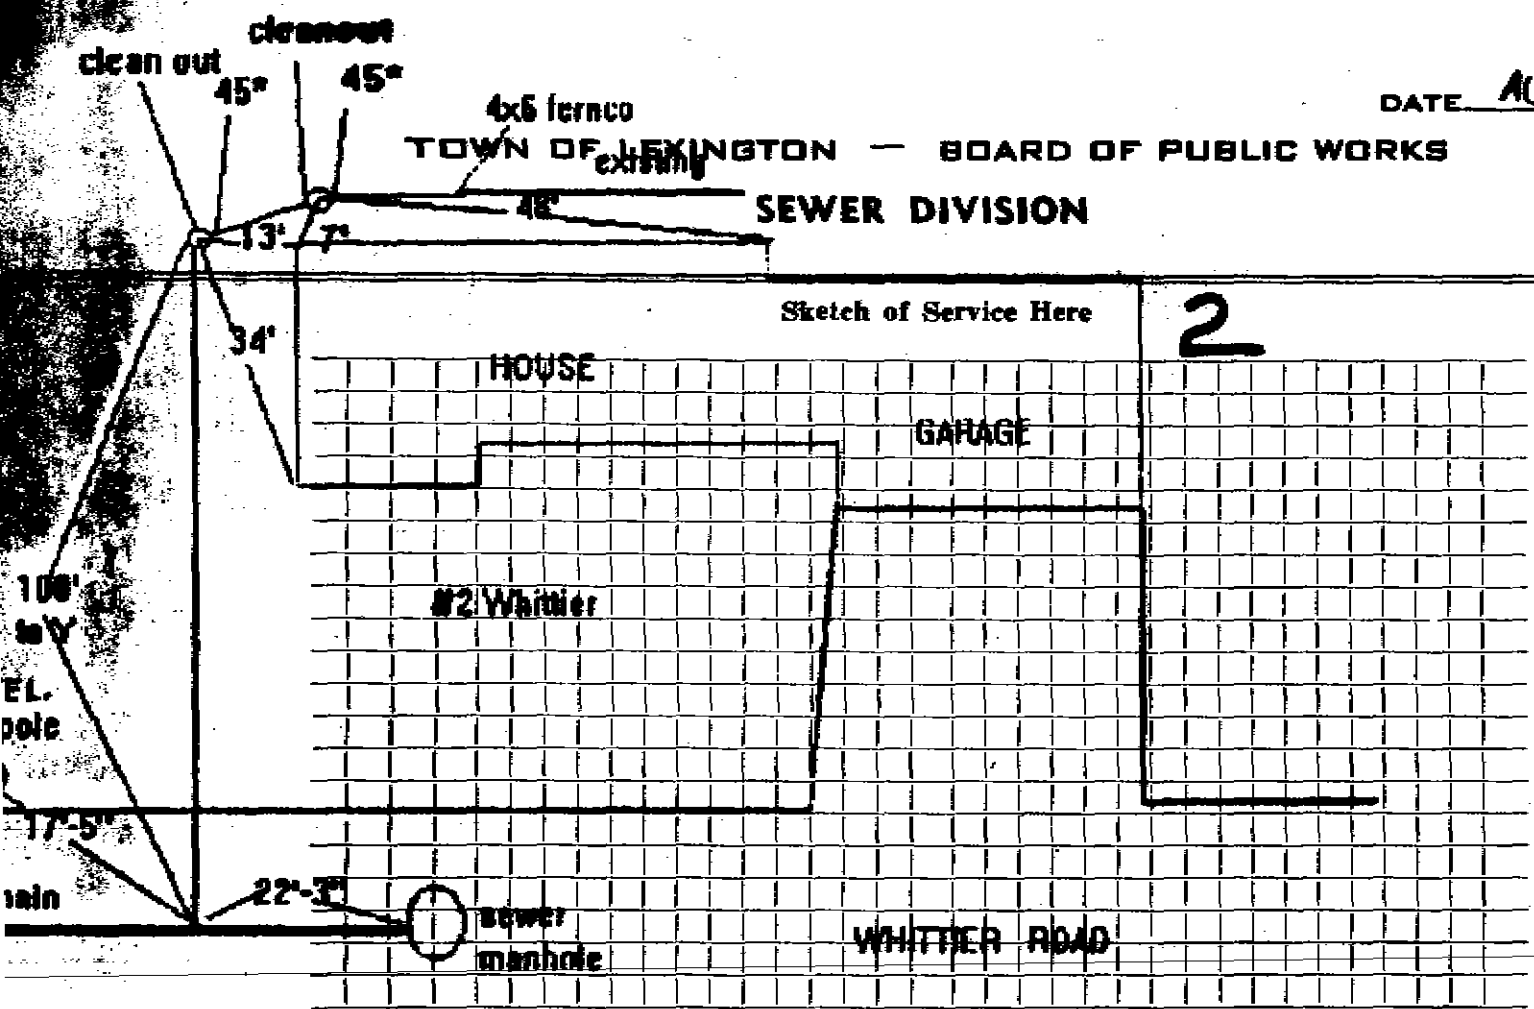

Connection made in \_\_\_\_\_ Street \_\_\_\_\_ Work completed \_\_\_\_\_ INSPECTOR: C.G. ....

Remarks: .....

