

Name

Service No.

Address

3 WHITTIER RD.

3 Whittier Road

Location

Kind of Pipe

PVC

Size

6"

Size of Main

Pg 22

Repair—Renewal—

New Service

J. M. McLAUGHLIN

PERMIT: 0678

Location

NB, St+V 95-2

Date

Material

Amount

Total

Date

Amount

AUG 75

1- CLEAN OUT

1- FERNCO

2- 45° ELBOWS


1- 22° ELBOW

147' - 6" PVC

DATE AUG. 75

TOWN OF LEXINGTON — 52 BOARD OF PUBLIC WORKS

SEWER DIVISION

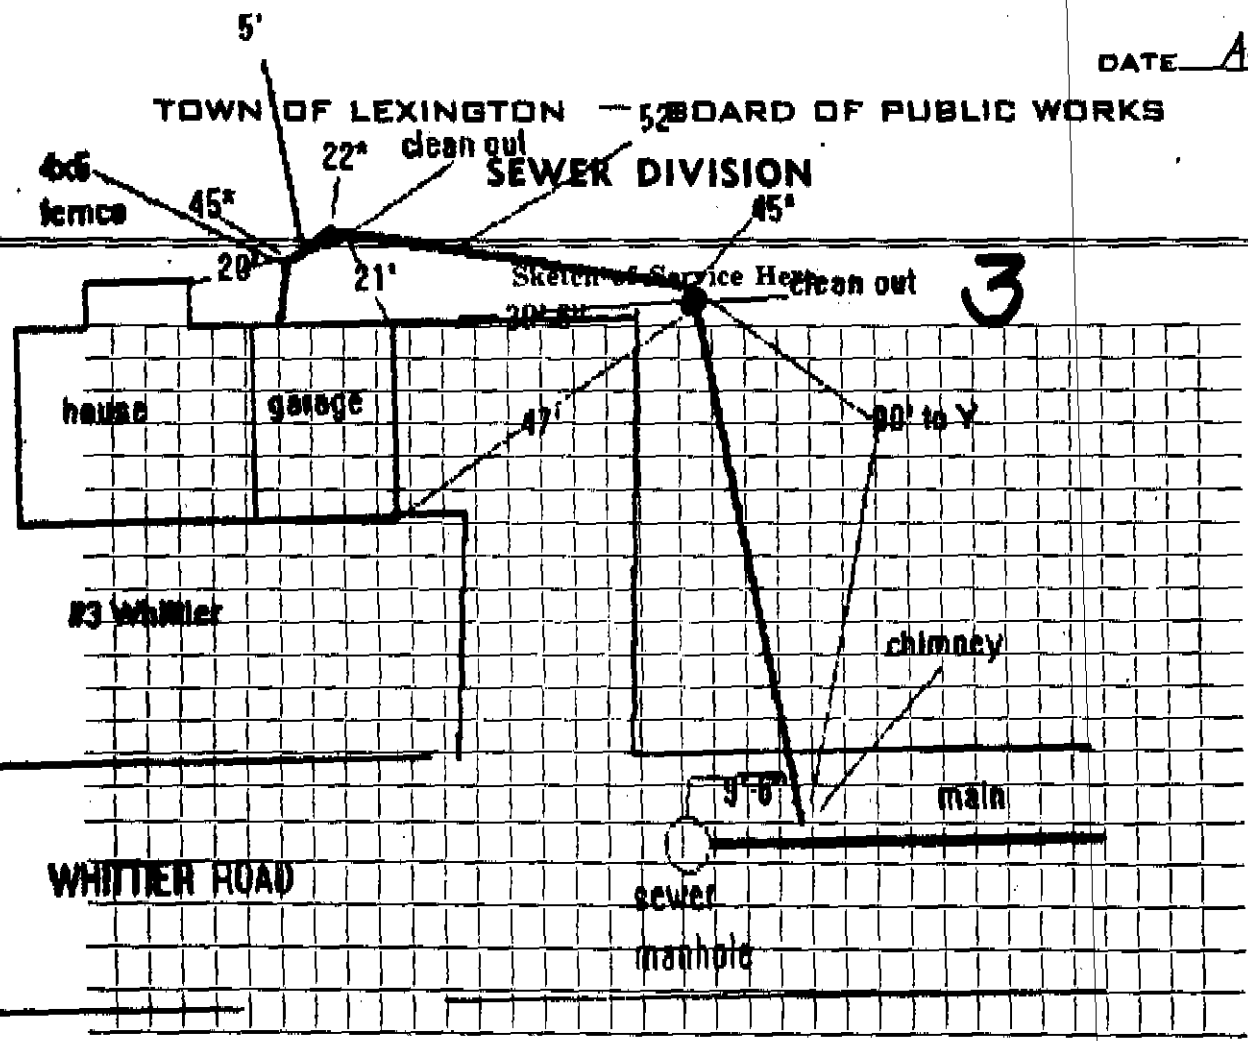

Connection made in WHITTIER RD Street.

Work completed INSPECTOR C. G.

Remarks: .....