


DATE 5-23-2000

TOWN OF LEXINGTON — BOARD OF PUBLIC WORKS
SEWER DIVISION

Sketch of Service Here

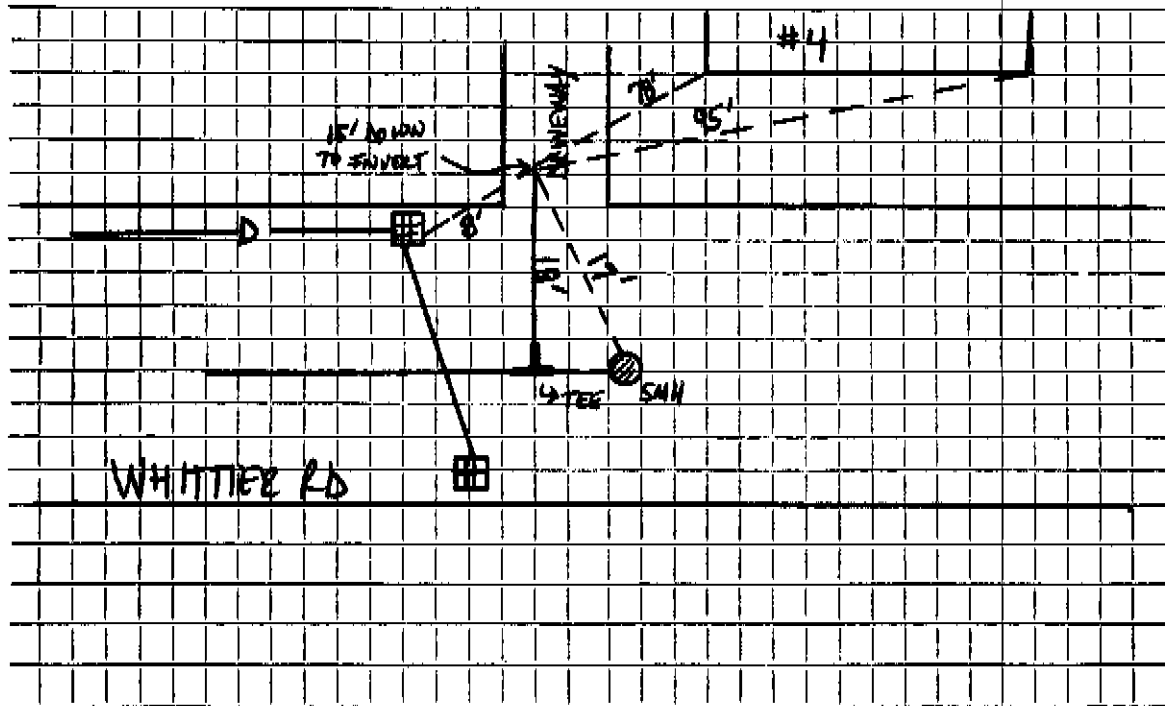

Connection made in .. WHITTIER RD Street. Work completed

Remarks: .18' OF 6" PVC LATERAL INSTALLED IN DRIVEWAY (TEE OF MAIN USED)

SERVICE PLACED IN LEDGE, LEDGE 5' DOWN FROM PAVEMENT, LEDGE 10' DOWN TO INVERT OF PIPE