


DATE 5-25-2000

TOWN OF LEXINGTON — BOARD OF PUBLIC WORKS
SEWER DIVISION

Sketch of Service Here

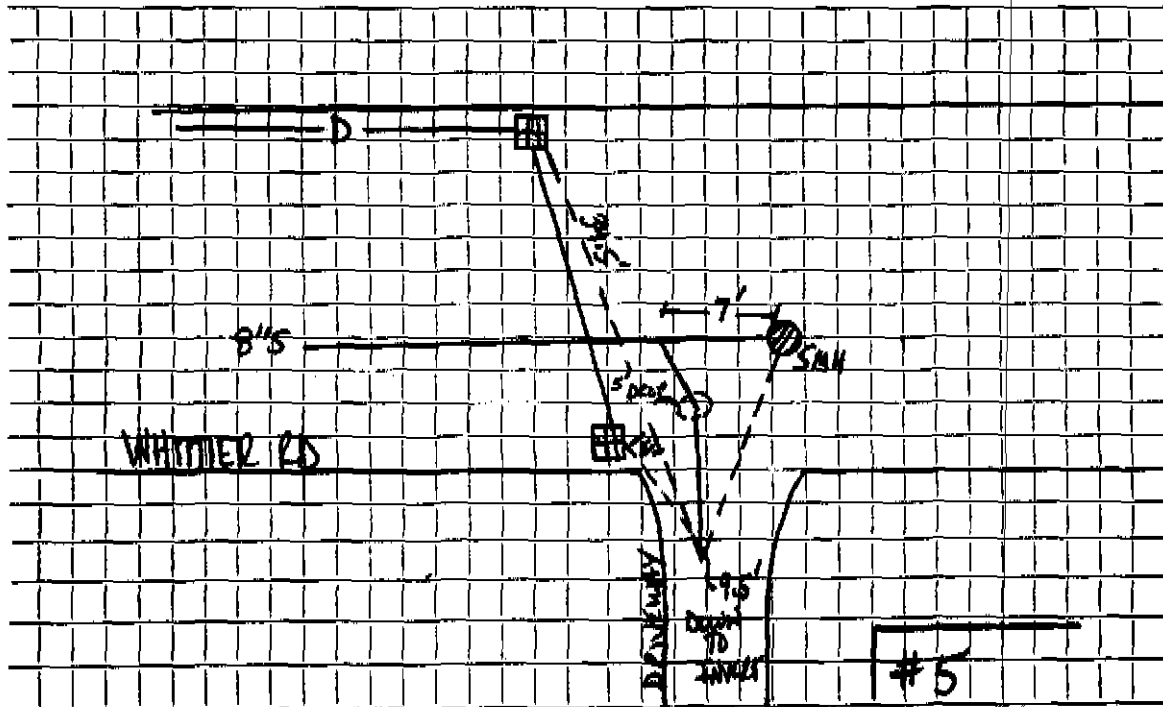

Connection made in Street. Work completed

Remarks: 28' OF 6" PVC IN PLACE INTO DRIVEWAY

SERVICE HAS A 5' DROP AFTER 22° BOND TO WYE ON MAIN