

Name Richard Bloom

Service No. 180

Address 7 Whittier Road

7 Whittier Road

Location

Kind of Pipe Valeri Const. Co. - Permit #150

Size 6"

Size of Main 8"

~~XXXXXXXXXX~~ - New Service W. O. #150

Location FEB 15 1965

Date	Material	Amount	Total	Date	Amount
11-17-64	Labor	68 00		11-2-64	150 00
	10% O.H.	6 80	74 80	1-23-65	11 30
	30' 6" Transite pipe @ .82		24 60		161 30
	1 12" Nipple		1 65		
	1 8 x 6 Wye		9 41		
	1 22 1/2 Bend		4 09		
	1 11 1/2 Elbow		2 35		
	18 x 3 Patch		18 00		
	9 Ton Gravel @ 1.10		9 90		
	1 Hr. Town Shovel		6 50		
	2 Hr. Town Truck @ 3.00		6 00		
	1 Hr. Loader		4 00		
			161 30		
11-20-64	72' 6" Transite Pipe				Bill sent 11 30


DATE _____

TOWN OF LEXINGTON — BOARD OF PUBLIC WORKS

SEWER DIVISION

Sketch of Service Here

7

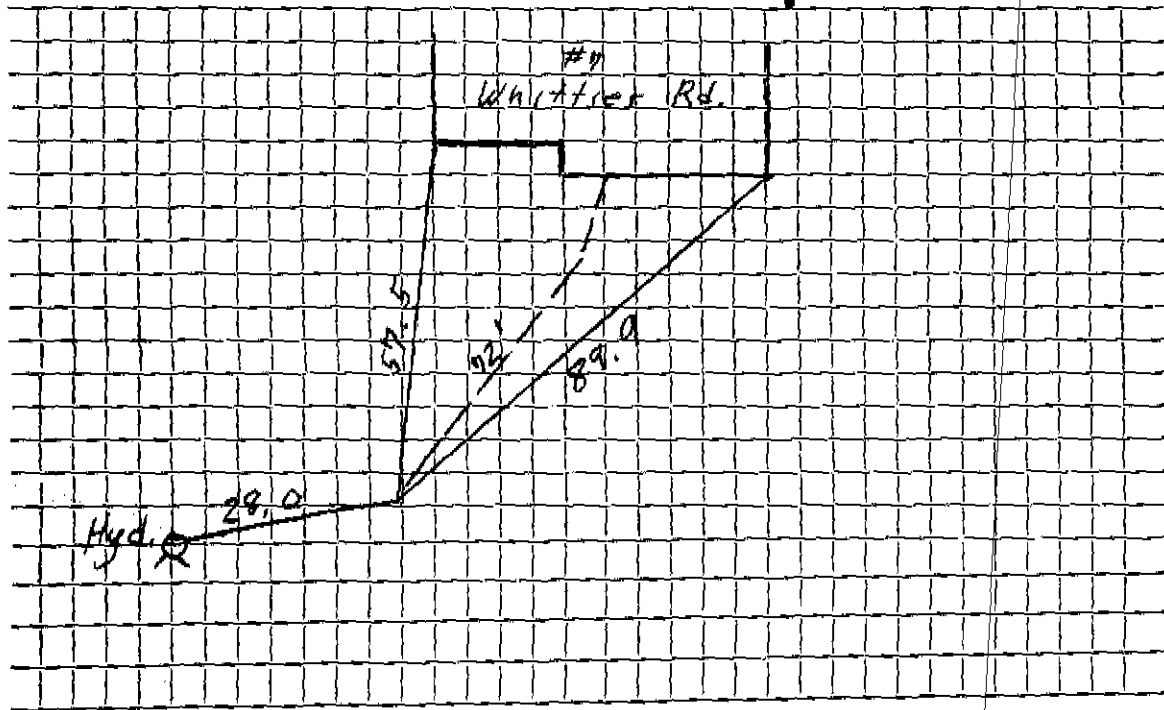

Connection made in Street. Work completed

Remarks:

.....

.....