

Name

Service No.

Address

1 Wildwood RD

Location

Kind of Pipe

PVC

Size 6"

Size of Main

Repair—Renewal—New Service

J McLaughlin

Location

Date

Material

Amount

Total

Date

Amount

12/16/02	7'	4" PVC sch 40					
	40'	6" PVC					
	1	4X6 Fernco					
	1	22 1/2" bend					
	1	6" ACX PVC Fernco					


EXIST A.C.

DATE _____

TOWN OF LEXINGTON — BOARD OF PUBLIC WORKS

SEWER DIVISION

Sketch of Service Here

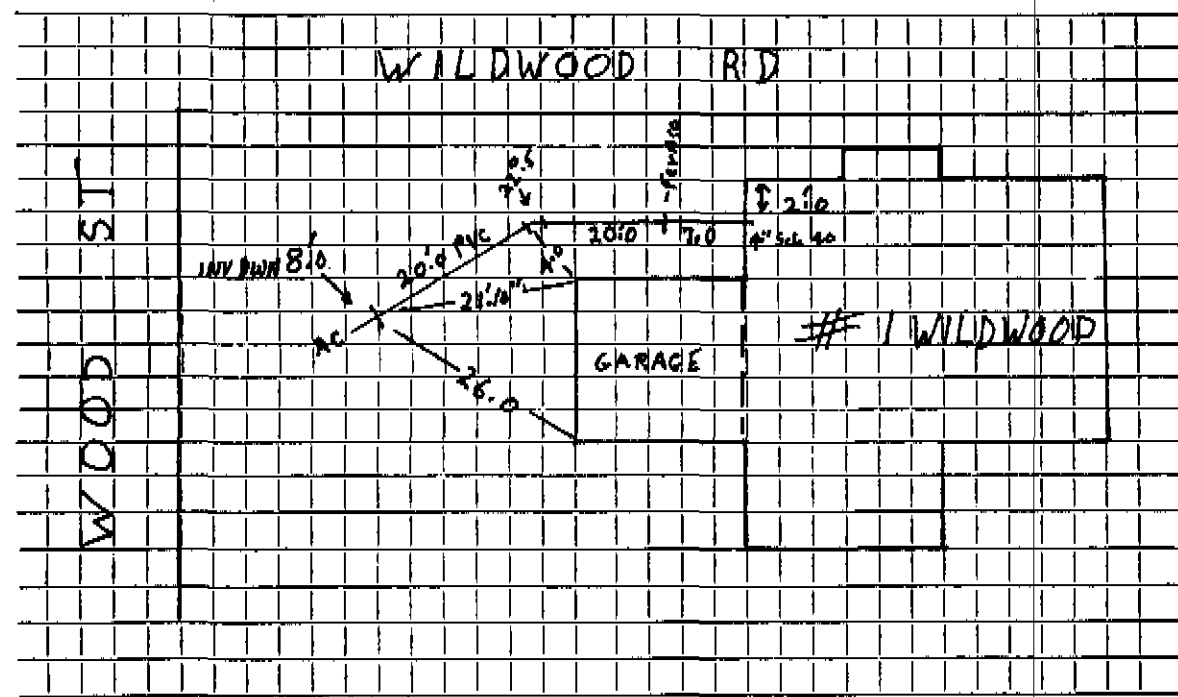

Connection made in Street. Work completed .. 12/16/02

Remarks:

Name Joseph G. Howland

Service No. 27

Address # 1 Wildwood Road

1 Wildwood Road

Location

Kind of Pipe

Size 6"

Size of Main 8"

Repair—Renewal—NEW SERVICE

Location Penn 5-16-60

Date	Material	Amount	Total	Date	Amount
4-13-60	Labor	9 50		4-4-60	Deposit
4-14-60	"	104 94		5-31-60	Paid
4-15-60	"	63 60			
	10 % O.H.	17 80	195 84		
	78' 6" Transite Pipe @.78		60 84		
	25 Ton 1 3/4 Stone @1.50		37 50		
	16 1/4 Ton Bank Gravel @.85		13 81		
	1 6" Transite Elbow 90°		5 29		
	5 Hrs. Town Shovel @6.50		32 50		
	4 Hrs. Trucking @3.00		20 00		
	8x3 Patche		8 00		
			373 78		


Bill sent 5-16-60 73.78

DATE _____

TOWN OF LEXINGTON — BOARD OF PUBLIC WORKS

SEWER DIVISION

Sketch of Service Here

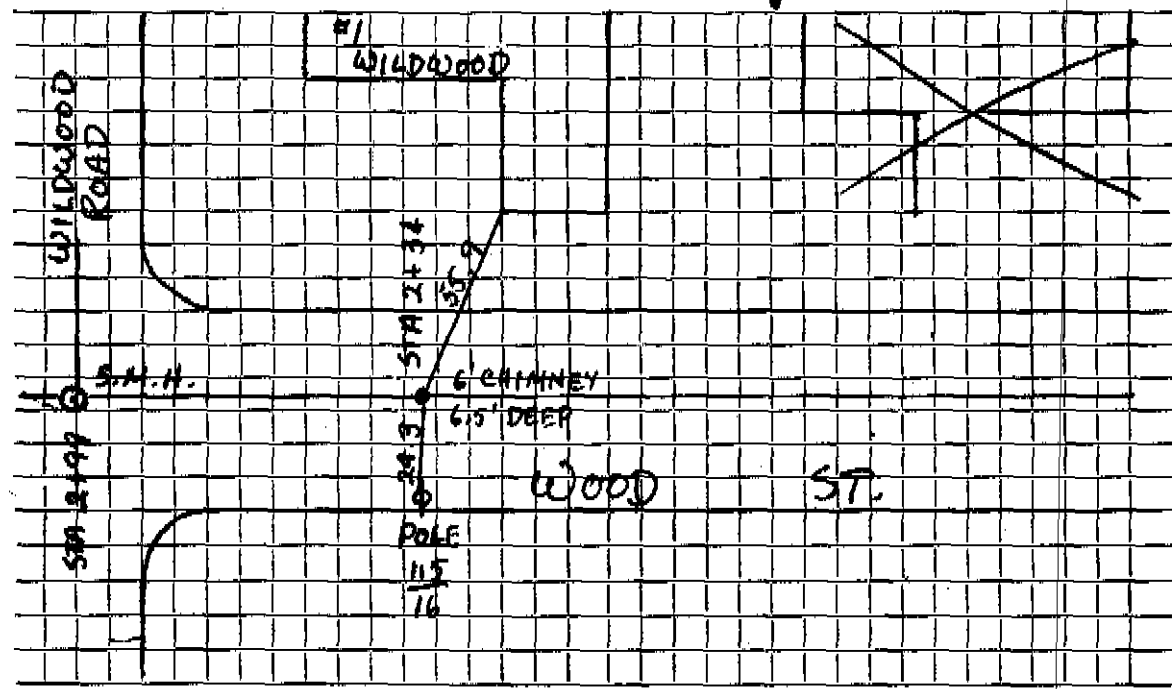

Connection made in Street. Work completed

Remarks:
.....
.....