

Theodore L. Freeman

Service No. 5

3 Wildwood Road

3 Wildwood Road

Location

Size of Pipe

Size 6"

Size of Main 8"

New Service

W.D. 301 Eagle #3367


Location MAY 21 1979

Item	Material	Amount	Total	Date		Amount
	Labor	123.70		7-18-79	Deposit	325.00
	10% O.R.	12.37	136.07	1-11-79	Paid	13.41
20'	6" Transite pipe @1.50		30.00			328.41
1	6" Nipple		1.93			
1	6" x 8" Saddle		22.29			
1	6" Cap		4.12			
1	ton Gravel @3.25		19.50			
1	hrs. Trucking @3.00		9.00			
1	hrs. Backhoe @6.50		19.50			
	Ext Top 5' x 18'		96.00			
			338.41			

DATE _____

TOWN OF LEXINGTON — BOARD OF PUBLIC WORKS
SEWER DIVISION

Sketch of Service Here **3**

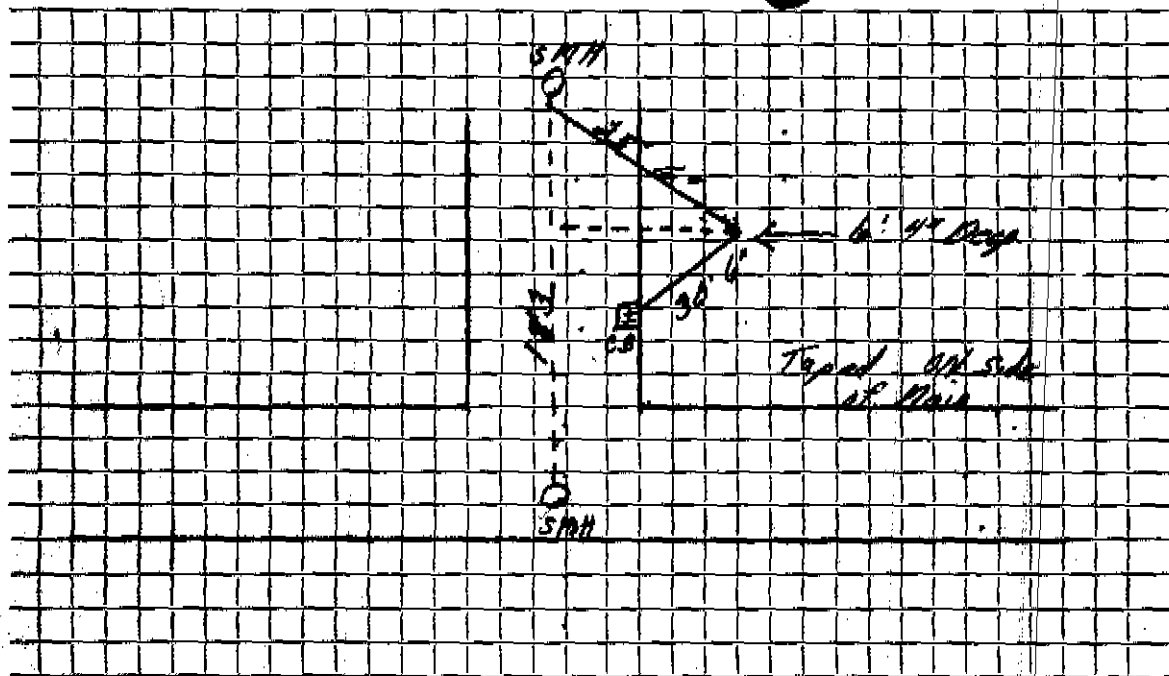

Connection made in Street. Work completed

Remarks:

.....

.....