

Mr. Arthur Morrissey

Service No.

2

4 Wildwood Road

Location

4 Wildwood Road

Size of Pipe

Size 6"

Size of Main 8"

New Service W.O. #7924 - Cont. Valeri Construction

Location MAY 27 1959


Date	Material	Amount	Total	Date	Amount
2-3-69	Labor	59 81		2-3-69	Deposit 180 00
2-9-69	"	17 13		4-9-69	Paid 35 05
	10% O.H.	7 69	84 63		145 05
	20' - Transite pipe .80		20 24		
	Bag cement 1.55		78		
	Ten cold patch 5/50		2 75		
	" hot top 5.80		2 90		
	Hrs. trucking 3.00		7 50		
	" " 1.50		75		
	" shovel 6.50		19 50		
	" compressor 5.00		2 50		
	" roller 3.00		1 50		
	Trailer		2 00		
			145 05		
	6" Transite pipe				
	4" Cast Iron pipe				

Bill sent 2505

DATE _____

TOWN OF LEXINGTON — BOARD OF PUBLIC WORKS
SEWER DIVISION

Sketch of Service Here **4**

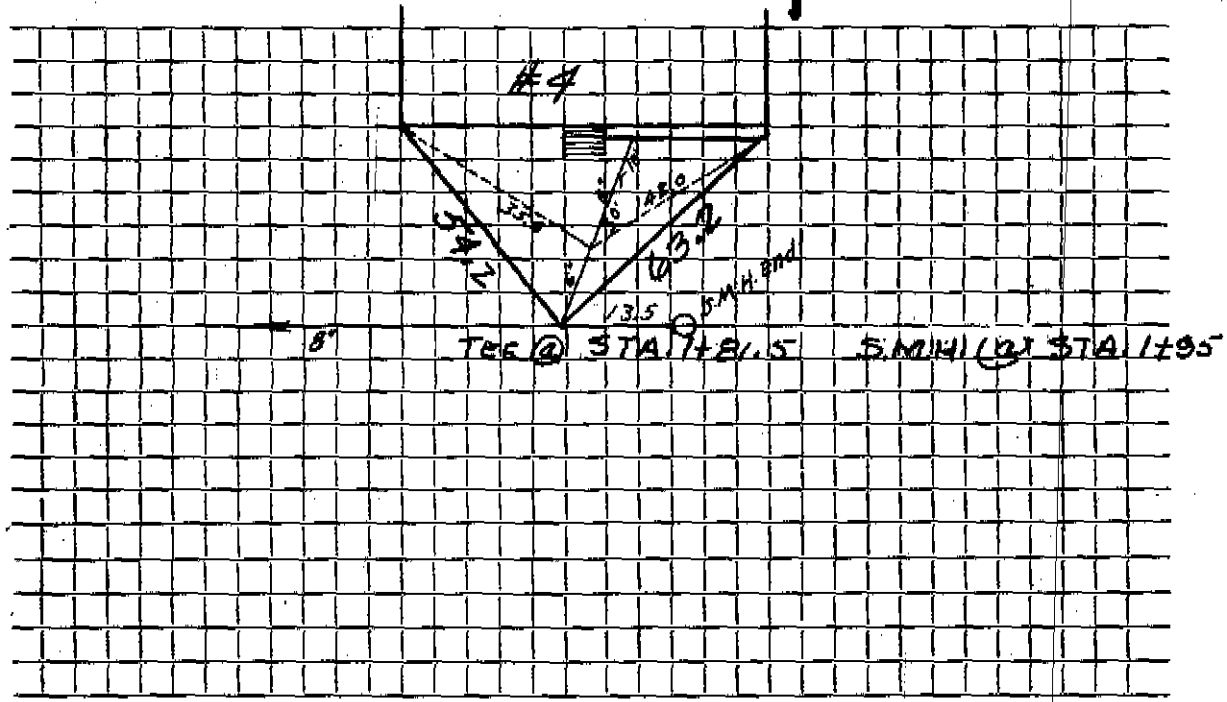

Connection made in Street. Work completed

Remarks:
.....
.....