

John Sahagian

Service No.

36

5 Wildwood Road

5 Wildwood Road

Location

Size of Pipe

Size 6"

Size of Main 8"

New Service

WOLF 8618

Location

Comm 6-18-64

Date	Material	Amount	Total	Date	Amount
	Lebor	\$1.04		3-31-64	350 50
	"	75.12		7-17-70	128 53
	"	62.34			478 53
	"	23.36	241.86		
	10% O.H.	26.29	266.05		
	6" Transite pipe @.82		72.98		
	1. Gaspool Cover & Frame		10.50		
	100 Brick @.20 per 100		8.40		
	2. Bag Cement @1.55		3.10		
	1 ton sand		1.00		
	13 yds. Leen @3.00		39.00		
	1 x 1 Patch		15.00		
	7 hr. Iron Shovel @6.50		45.50		
	4 hrs. Trucking @3.00		12.00		
	1 hr. Compressor @5.00		5.00	10 17 165	Perls at member
			478.53		


DATE \_\_\_\_\_

**TOWN OF LEXINGTON — BOARD OF PUBLIC WORKS**  
**SEWER DIVISION**

Sketch of Service Here

5

SS, For # 5

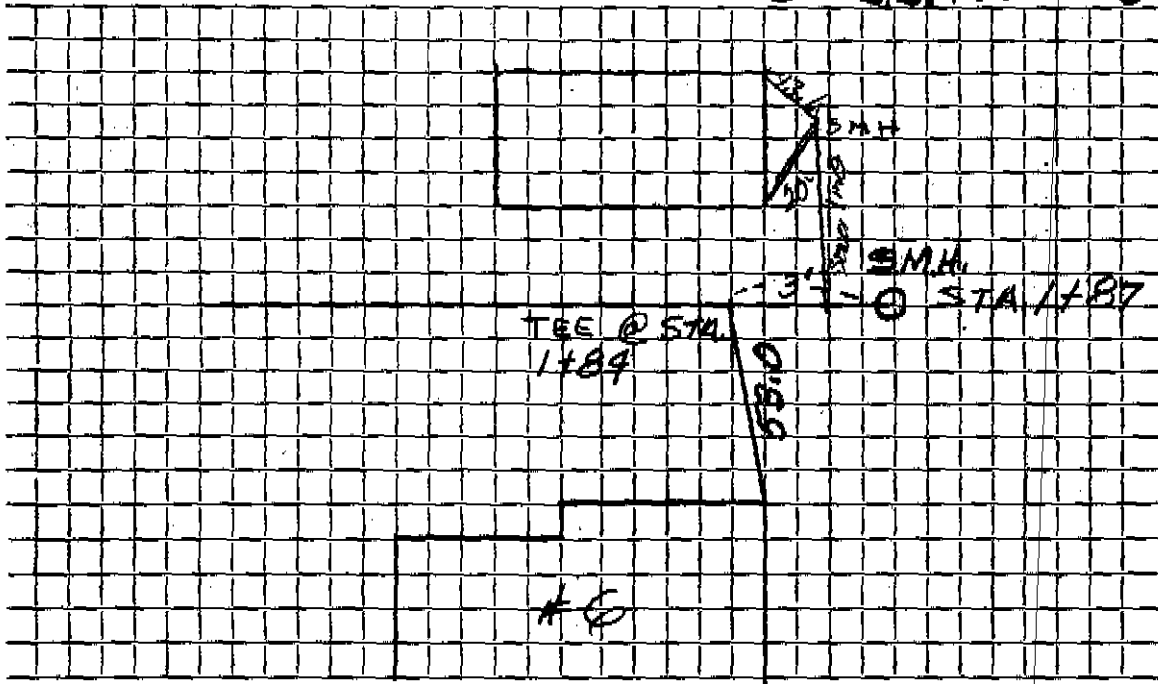

Connection made in ..... Street. Work completed .....

Remarks: .....

.....

.....