

Name John P. Mearls

Service No. 195

Address Wildwood ~~St~~ Road

Wildwood Road

Location

Size of Pipe

Size 6"

Size of Main 8"

Work - New Service

IO # 8332

Location ~~On~~ 5-18-64

Date	Material	Amount	Total	Date	Amount
12-16-63	Labor	111.99		11-20-63	350.00
1-9-64	"	18.99	128.98	6-26-64	9.99
	10% O.H.	12.90	141.88		259.99
	1/4" 6" Transite Pipe @.82		36.08		
	2 22 1/2° Transite Bends @4.09		8.18		
	1 1 1/2° Transite Elbow		2.35		
	12 X 4 Patch		16.00		
	6 Yards Loan @3.00		18.00		
	3 Hrs. Town Shovel @6.50		19.50		
	5 Hrs. Trucking @3.00		15.00		
	1 Hr. Trailer @3.00		3.00		
			259.99		

Bill sent 999


DATE _____

TOWN OF LEXINGTON — BOARD OF PUBLIC WORKS

SEWER DIVISION

Sketch of Service Here

6

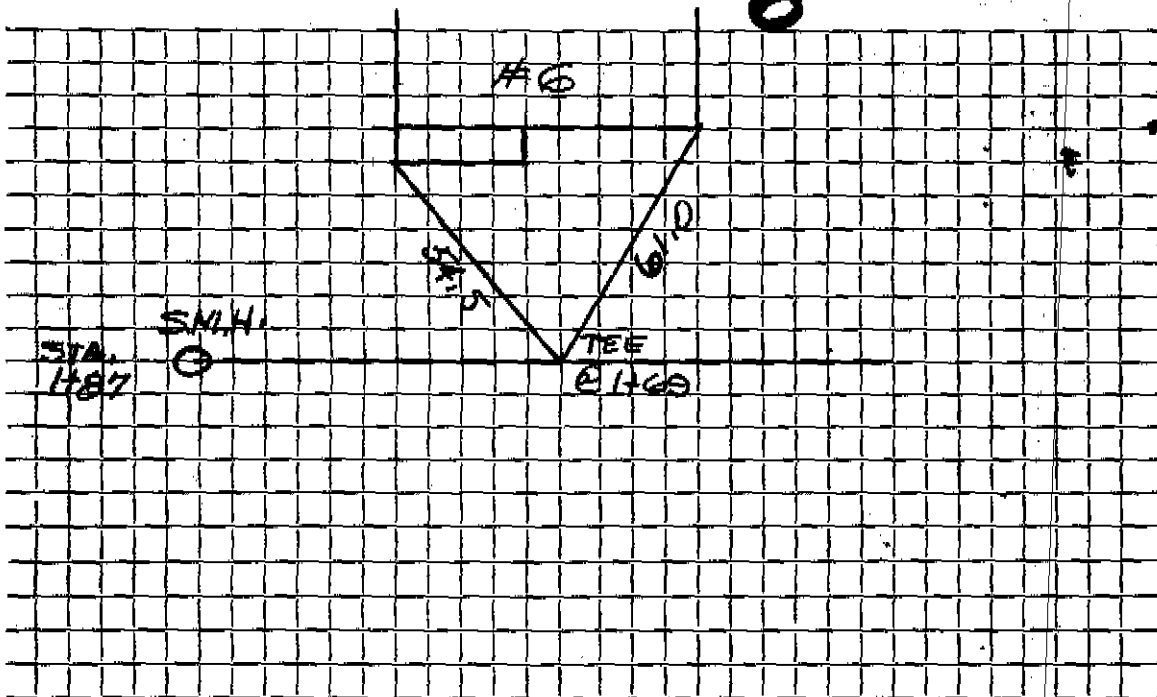

Connection made in Street. Work completed

Remarks:

.....

.....