

Paul Mac Donnell

Service No. 218

7 Wildwood Road  
7 Wildweed Road

Location

Size of Pipe

Size 6"

Size of Main 8"

New Service

Location *Comm 12-31-60*

Date	Material	Amount	Total	Date	Amount
11-2-60	Labor	38.50		11-2-60	Deposit 450.00
11-2-60	"	28.23	66.73	12-7-60	Ret. 79.00
	10% O.H.	6.67	73.40		171.00
65'	6" Transit pipe @ .78		50.70		
1	6" Transit 90° Elbow		5.20		
5	hrs. Pippin Shovel @ 4.50		22.50		
3	hrs. Trucking @ 3.00		9.00		
10 x 3	Patch		30.00		
			<u>171.00</u>		


DATE \_\_\_\_\_

# TOWN OF LEXINGTON — BOARD OF PUBLIC WORKS

## SEWER DIVISION

Sketch of Service Here

7 SS. For #7

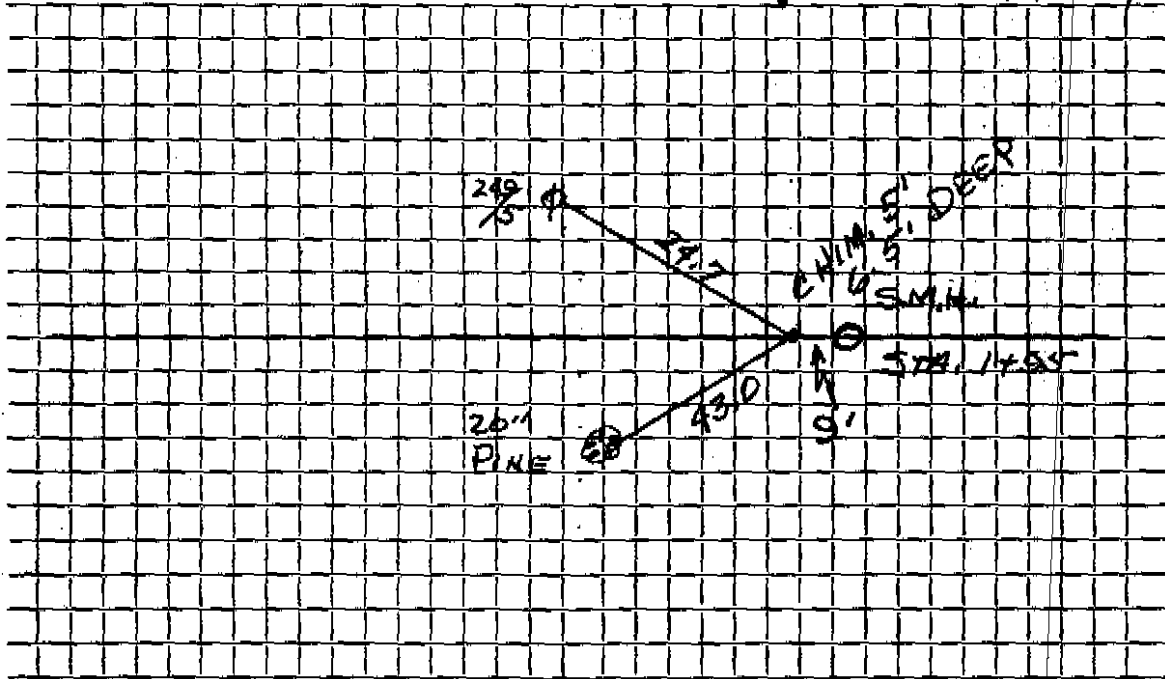

Connection made in ..... Street. Work completed .....

Remarks: .....

.....

.....