

Name Robert Hamlon

Service No. 96

Address 8 Wildwood Road

8 Wildwood Road

Location

Kind of Pipe

Size 6"

Size of Main 8"

~~XXXXXXXXXX~~ New Service Trebino #3507 W.O. #872

Location Jan 21, 1980


Date	Material	Amount	Total	Date	Amount
11-9-79	Labor	109.62		11-15-79	275.00
	10% O.H.	10.96	120.58	1-4-80	17.39
	1 6" 90° Elbow		6.21		292.99
	1 6" 30° Elbow		11.22		
	10' 6" Transite pipe @1.91		19.10		
	1 6" x 5' Nipple @ 2.45		12.25		
	1 6" x 2' Nipple		7.60		
	1 6" Plug		2.95		
	1/2 bag Cement		2.49		
	3 yds. Gravel @3.25		9.75		
	2 hrs. Trucking @3.00		6.00		
	3 hrs. Backhoe @6.50		19.50		
	Hot Top 8' x 14'		74.64		
			292.29		
11-14-79	25' 6" Transite pipe				
	10' 4" Cast Iron pipe				

Bill sent 1/2/80

DATE \_\_\_\_\_

**TOWN OF LEXINGTON — BOARD OF PUBLIC WORKS**  
**SEWER DIVISION**

Sketch of Service Here **8**

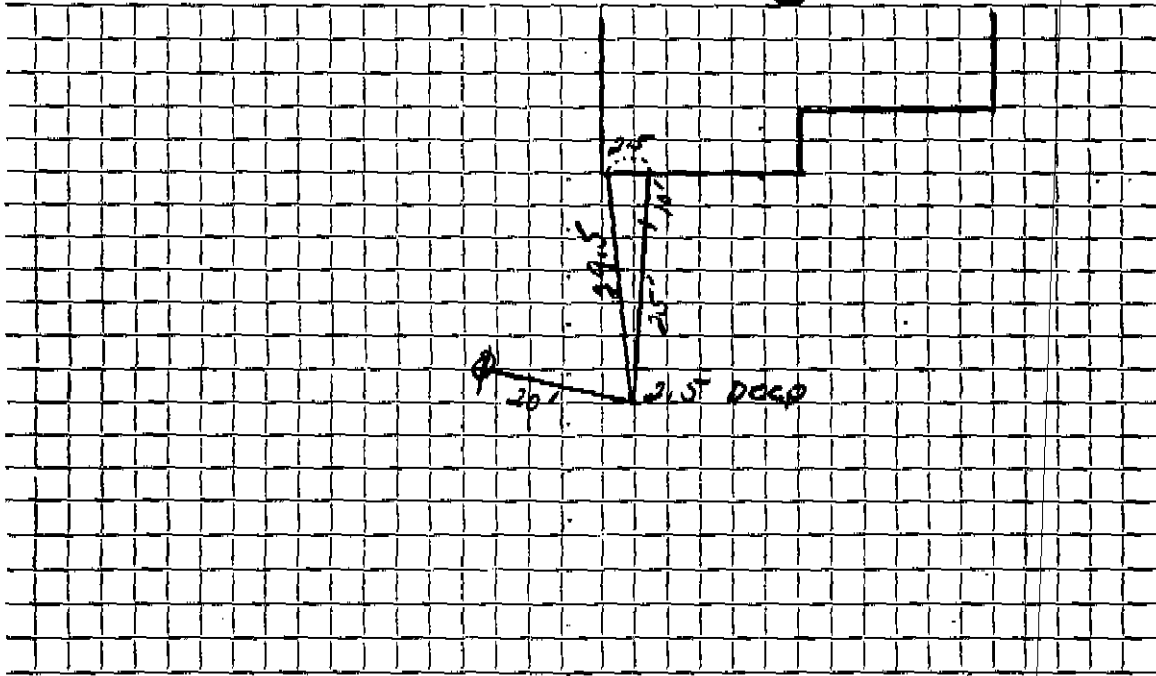

Connection made in ..... Street. Work completed .....

Remarks: .....  
.....  
.....