

Owner William H. McNamara

Service No. 163

Address 9 Wildwood Road

9 Wildwood Road

Location

Kind of Pipe

Size 6"

Size of Main 8"

~~XXXXXXXXXX~~ New Service

WO# 7660

Location

Comm 12-10-62


Date	Material	Amount	Total	Date	Amount
11-29-62	Labor	96.87		11-2-62	300.00
	10% O.H.	9.69	206.56	12-10-62	63.15
	60' 6" Transite pipe @82		49.20		236.85
	1 90° Transite Elbow		4.09		
	12 K 3 Patch		12.00		
	6 Hrs. Town Shovel @6.50		39.00		
	2 Hrs. Trucking @3.00		6.00		
	Spring Loaming & Seeding ('63)		20.00		
			236.85		

Deposit  
ReFund

DATE \_\_\_\_\_

TOWN OF LEXINGTON — BOARD OF PUBLIC WORKS  
SEWER DIVISION

Sketch of Service Here **9**

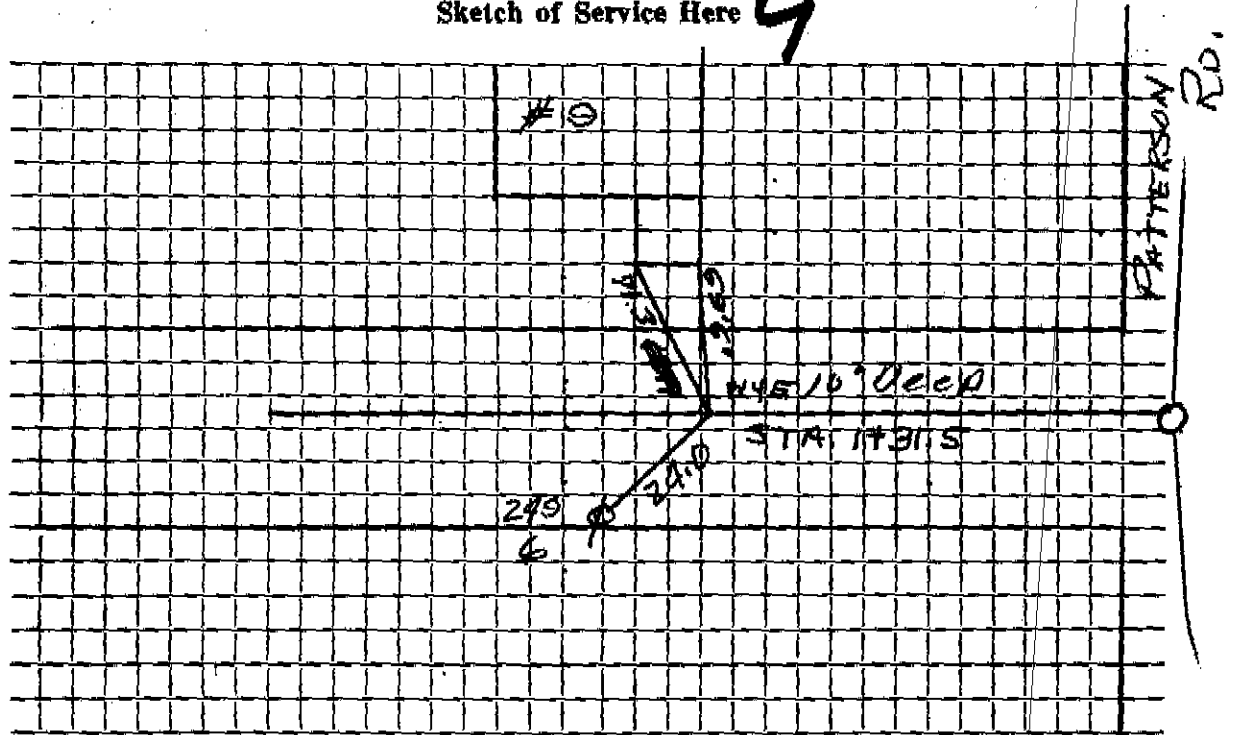

Connection made in ..... Street. Work completed .....

Remarks: .....