


TOWN OF LEXINGTON — BOARD OF PUBLIC WORKS
SEWER DIVISION

#9

Sketch of Service Here

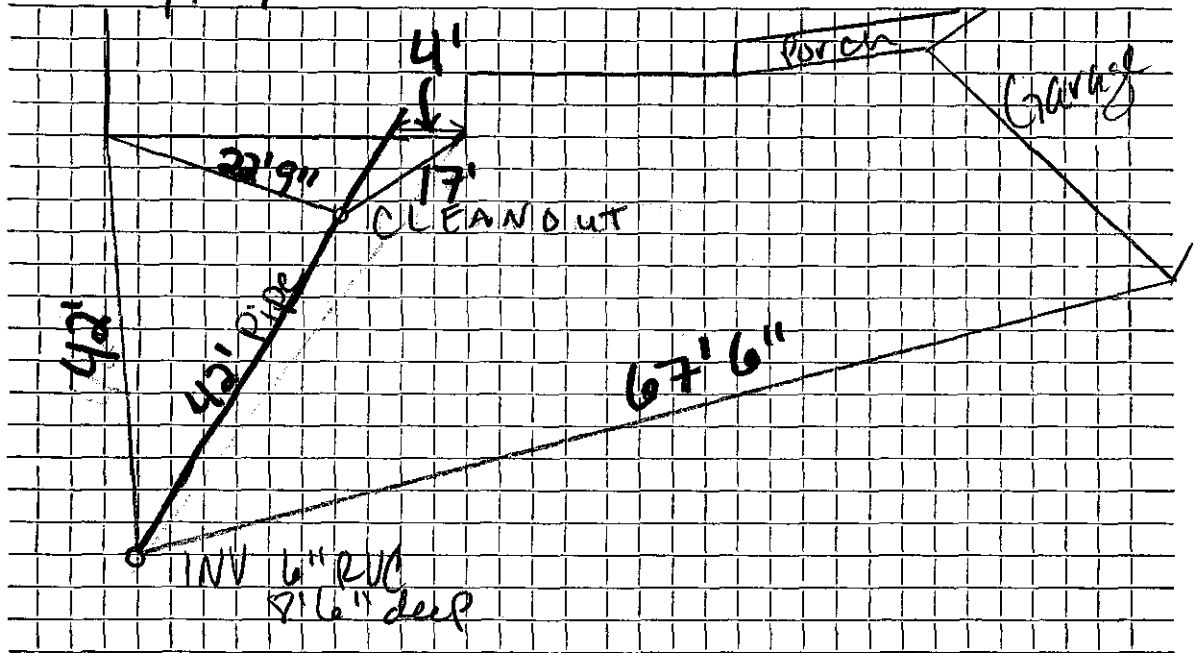

Connection made in 9 Willard Circle Street. Work completed

Remarks:
.....
.....