

Name William H. Sullivan

Service No. 131

Address 15 Williams Road

Lexington *15 Williams Road* Location

Kind of Pipe COM. 9-22-52

Size 6"

Size of Main 10"

~~Repair~~ ~~Renew~~ New Service

Location

Date	Material	Amount	Total	Date	Amount
9/5/52	Labor	59 13		9-22-52	Deposited 125 --
	10% overhead	5 91	65 04	9-22-52	Refunded 16 42
	46' - 6" sewer pipe @ .342		15 73		" credited 1 67
	1 - 6" elbow		1 88		for r.c. #193) C
	joint compound		2 76		
	4 hrs. town shovel @ 5.00		20 00		
	2 hrs. trucking		1 50		
			106 91		106 91
	Labor				

# TOWN OF LEXINGTON—DEPT. OF PUBLIC WORKS

## SEWER DIVISION

DATE.....

NO.....

The undersigned applies for the construction of a particular sewer connecting No.....  
 Street and hereby agrees to comply with the Rules and Regulations governing the construction and use of Particular  
 Sewers, as now or at any future time established by the Board of Selectmen.


Am't of estimate \$.....

Am't Paid \$.....

..... Owner

Sketch of Service Here

15

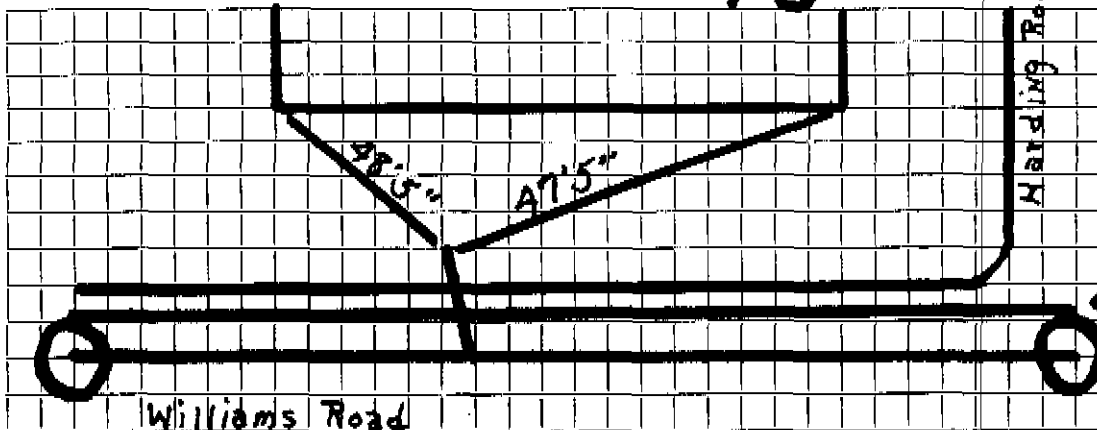

← 24" D.I. Forced main

Connection made in..... Street.

Work completed.....19..

Remarks: