

Name **W. T. Bosson**

Service No. **46**

Address ~~323 1/2 First Street~~ **3 Williams Road**

Lexington *per Eng 12-9-99* Location

Kind of Pipe **NEW SERVICE** Size **COM.** Size of Main

~~NEW SERVICE~~ **New Service** **COM. 7-28-52** Location

Date	Material	Amount	Total	Date	Amount
6/16/52	Labor	45 28		7-18-52	Deposited 115 00
6/17/52	"	8 54	53 82	7-28-52	Refunded (9 02
	10% overhead		5 38		115 98
	60' - 6" sewer pipe @ .342		20 52		
	1 - 6" elbow		1 88		
	1 - 6" Tee		1 28		
	Joint compound		3 60		
	4 hrs. Littlefield shovel		28 00		
	2 hrs. trucking		1 50		
			<u>115 98</u>		
	Labor				

TOWN OF LEXINGTON—DEPT. OF PUBLIC WORKS
SEWER DIVISION

DATE

NO.


The undersigned applies for the construction of a particular sewer connecting No.
Street and hereby agrees to comply with the Rules and Regulations governing the construction and use of Particular
Sewers, as now or at any future time established by the Board of Selectmen.

Am't of estimate \$.....

Am't Paid \$.....

..... Owner

Sketch of Service Here **343**

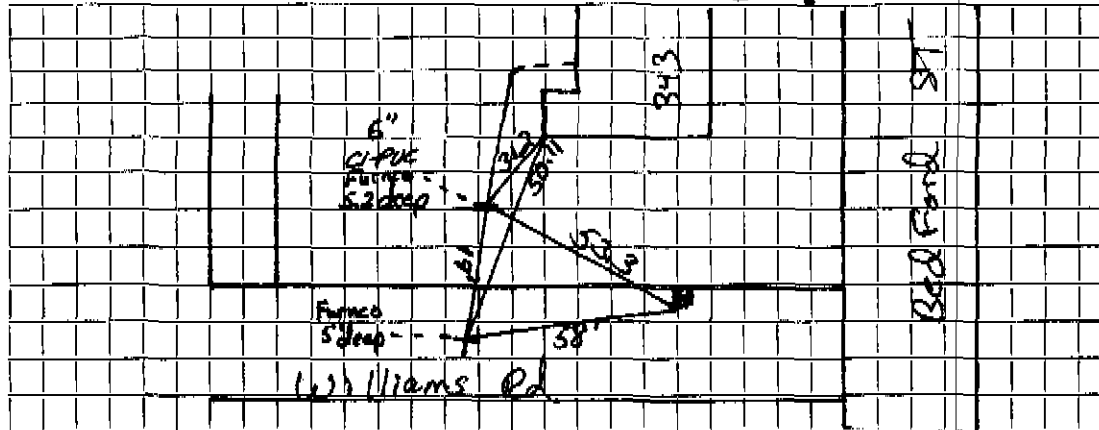

Connection made in

Street.

Work completed

19..

Remarks: