

Name Courtney Comeau

Service No. 131

Address 32 Williams Road

Lexington, Mass. 32 Williams Rd. Location

Kind of Pipe

Size 6"

Size of Main 8"

~~XXXXXX~~ New Service

C. U. M. 11-13-51

Location

Date	Material	Amount	Total	Date		Amount
9/29/51	Labor	15 39	15 39	9-19-51	Deposited	125 -
	10% overhead		1 54	11-13-51	Refunded	40 45
	60' -6" sewer pipe @ .342		20 52			84 55
	joint compound		3 60			
	6 hrs. Littlefield shovel @ .70		42 00			
	2 hrs. trucking @ .75		1 50			
			84 55			
	Labor					

TOWN OF LEXINGTON—DEPT. OF PUBLIC WORKS

SEWER DIVISION

DATE

NO.


The undersigned applies for the construction of a particular sewer connecting No. Street and hereby agrees to comply with the Rules and Regulations governing the construction and use of Particular Sewers, as now or at any future time established by the Board of Selectmen.

Am't of estimate \$.....

Am't Paid \$.....

..... Owner

Sketch of Service Here

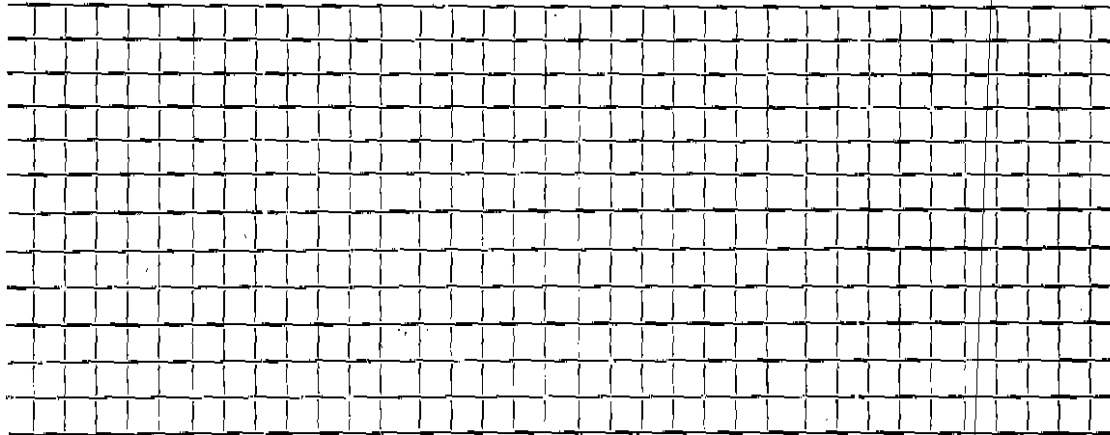

Connection made in Street.

Work completed 19..

Remarks: