

Name C. Courtney Comeau

Service No. 99

Address 36 Williams Road

36 Williams Road

Location

Kind of Pipe

COM. 8-30-54

Size 6"

Size of Main 8"

Repair - Renewal - New Service

~~SEWER MAIN~~

Location

Date	Material	Amount	Total	Date	Amount
7/13/54	Labor	23 86		6-22-54	Deposited 125 00
	10% overhead	2 39	26 25	8-30-54	*Refunded (54 59)
	56' - 6" sewer pipe @ .30		16 80		70 41
	joint compound		3 36		
	3 hrs. Littlefield shovel @ 7.50		22 50		
	2 hrs. trucking @ .75		1 50		
			70 41		* \$120 made payable to town to apply and bal due on W.P.C. #143
	Labor				

TOWN OF LEXINGTON—DEPT. OF PUBLIC WORKS
SEWER DIVISION

DATE.....

NO.


The undersigned applies for the construction of a particular sewer connecting No.....
Street and hereby agrees to comply with the Rules and Regulations governing the construction and use of Particular
Sewers, as now or at any future time established by the Board of Selectmen.

Am't of estimate \$.....

Am't Paid \$.....

..... Owner

Sketch of Service Here

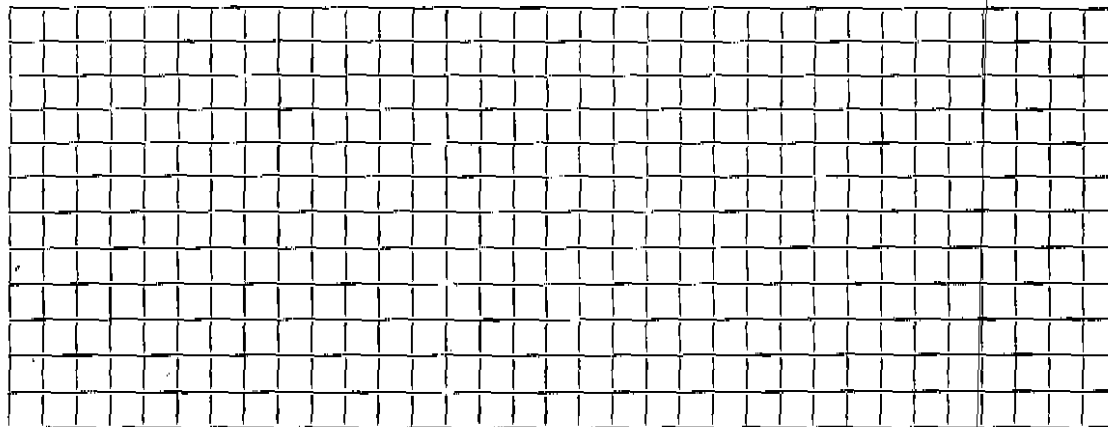

Connection made in..... Street.

Work completed.....19..

Remarks: