

Name William Mara

Service No. 206

Address 51 Williams Rd.

Lexington 51 Williams Road Location

Kind of Pipe

Size 6"

Size of Main 8"

REPAIR/RENEW - New Service

Com. 12-21-53

Location

Date	Material	Amount	Total	Date	Amount
12/9/53	Labor	55 85		12-1-53	Deposited 150 00
	10% overhead	5 59	61 44	12-21-53	Paid 9/6 90
	40'-6" Sewer pipe @ .37		14 80	12-24-53	Paid 00
	Joint compound		2 40	5-25-53	150 92
	2 Hr. town shovel @ 5.00		10 00		16' 6" Sewer Pipe
	2 hr. trucking		1 50		1 6"-1/8" Bend
			90 14		2 ^d drawing - bill sent 12-21-53
	Ples attached card:		60 78		
	Total charge:		150 92		
	Labor				

TOWN OF LEXINGTON—DEPT. OF PUBLIC WORKS
SEWER DIVISION

DATE

NO.


The undersigned applies for the construction of a particular sewer connecting No.
Street and hereby agrees to comply with the Rules and Regulations governing the construction and use of Particular
Sewers, as now or at any future time established by the Board of Selectmen.

Am't of estimate \$.....

Am't Paid \$.....

..... Owner

Sketch of Service Here

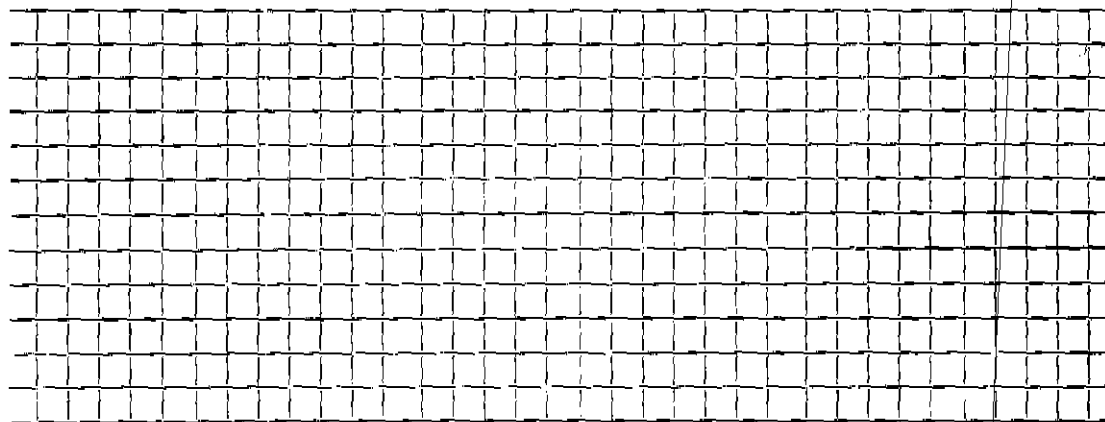

Connection made in Street.

Work completed 19..

Remarks: