

Name

Service No. 2637

Address

52 Williams RD

Location

Lot 260

Kind of Pipe

PVC

Size

6"

Size of Main

8"

Repair—Renewal—New Service

J.M.C.

Location

Date

Material

Amount

Total

Date

Amount

10/13/07

6'

Sch 40-6" PVC

49'

6" PVC

1

4x6 Ferno

1

22° bend

1

1 1/4" bend

1

6" PVC x A.C. Ferno 8' 6" bend


1970

Renew outside A.C. or PVC ?

DATE _____

TOWN OF LEXINGTON — BOARD OF PUBLIC WORKS
SEWER DIVISION

Sketch of Service Here

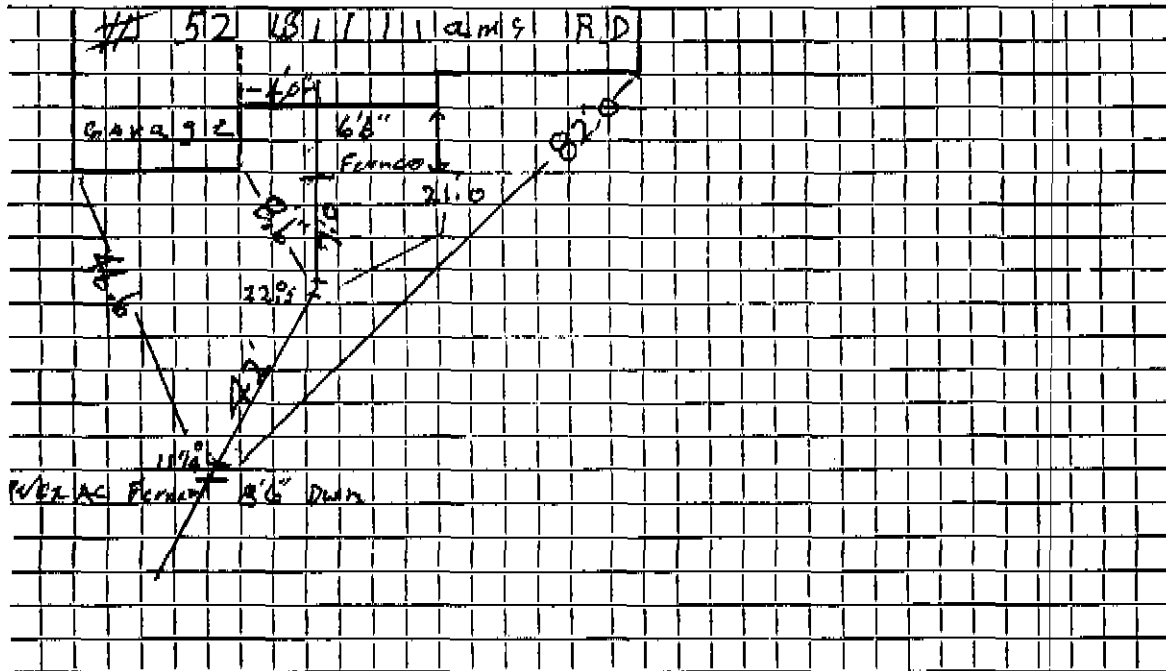

Connection made in Street. Work completed .. 10/13/97 .. J. Picl

Remarks:
.....
.....