

Name C. Courtney Comeau

Service No. 69

Address 53 Williams Road

Lexington 53 Williams Road

Location

Kind of Pipe

Size 6"

Size of Main 8"

~~Repair/Alteration~~ New Service

COM. 6-8-53

Location

Date	Material	Amount	Total	Date	Amount
5/13/53	Labor	70 50		4-21-53	Deposited 125 00
	10% overhead	7 05	77 55	6-8-53	* Refunded () 75
	58' - 6" sewer pipe @ .342		19 84		<u>NON CHARGE</u> 124 25
	1 - 6" elbow		1 88	5/14/53	Labor 35 19
	joint compound		3 48		
	4 hrs. town shovel @ 5.00		20 00		
	2 hrs. trucking		1 50		
			124 25		
					* This refund made payable to town of Lex so apply to bal due on sewer con. #68
	Labor				

TOWN OF LEXINGTON—DEPT. OF PUBLIC WORKS
SEWER DIVISION

DATE.....

NO.


The undersigned applies for the construction of a particular sewer connecting No.....
Street and hereby agrees to comply with the Rules and Regulations governing the construction and use of Particular
Sewers, as now or at any future time established by the Board of Selectmen.

Am't of estimate \$.....

Am't Paid \$.....

..... Owner

Sketch of Service Here

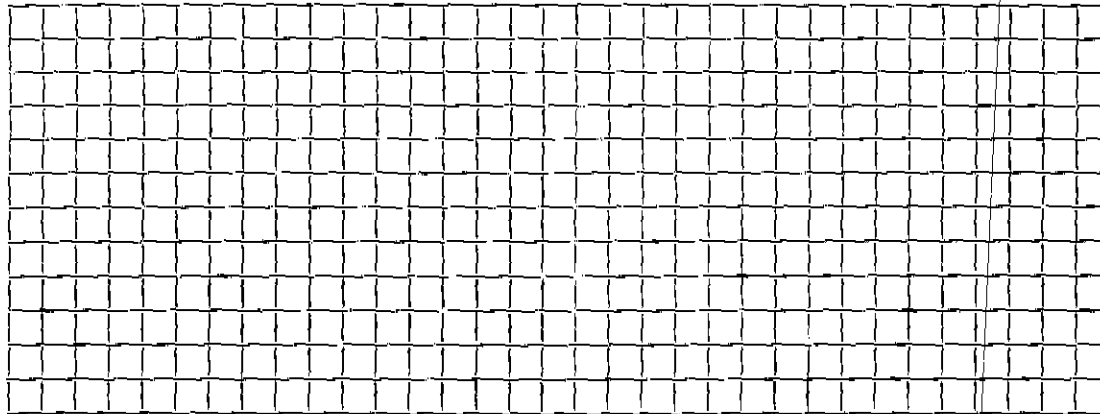

Connection made in..... Street.

Work completed.....19..

Remarks: