

Name C. Courtney Comeau

Service No. 68

Address 55 Williams Road

Lexington 55 Williams Road Location

Kind of Pipe

Size 6"

Size of Main 8"

REPAIR/RENEW - New Service

COM. 6-8-53

Location

| Date | Material | Amount | Total | Date | Amount |
|---------|----------------------------|--------|--------|-------------------|-------------------|
| 5/12/53 | Labor | 85 70 | | 7-17-53 Deposited | 125 00 |
| | 10% overhead | 8 57 | 94 27 | 6-8-53 | 125 00 |
| | 58' - 6" sewer pipe @ .342 | | 19 84 | 7-24-53 Paid | 15 97 |
| | 1 - 6" elbow | | 1 88 | | NON CHARGE |
| | joint compound | | 3 48 | 5/13/53 Labor | 33 30 |
| | 4 hrs. town shovel @ 5.00 | | 20 00 | | |
| | 2 hrs. trucking | | 1 50 | | |
| | | | 140 97 | | |
| | Labor | | | | |

6-8-53

TOWN OF LEXINGTON—DEPT. OF PUBLIC WORKS
SEWER DIVISION

DATE.....

NO.


The undersigned applies for the construction of a particular sewer connecting No.....
Street and hereby agrees to comply with the Rules and Regulations governing the construction and use of Particular
Sewers, as now or at any future time established by the Board of Selectmen.

Am't of estimate \$.....

Am't Paid \$.....

..... Owner

Sketch of Service Here

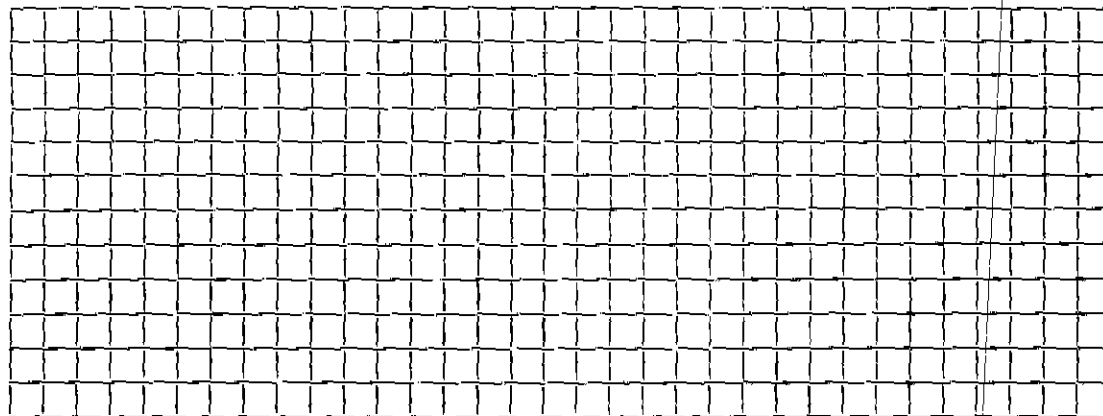

Connection made in..... Street.

Work completed.....19..

Remarks: