

Name

Service No. 1750

Address 58 Williams Rd.

Location

Kind of Pipe PVC

Size 6"

Size of Main

Repair—Renewal—New Service *Teardown T. McLaughlin*


Location

Date	Material	Amount	Total	Date	Amount
4/26/05	7.0 4" PVC sch 40				
	40' 6" PVC				
	1 1.0x6" Nipple				
	1 6" clay x PVC Farnco				
	1 4x6 Farnco				
	1 22° bend				
	Excess Clay				

DATE _____

TOWN OF LEXINGTON — BOARD OF PUBLIC WORKS
SEWER DIVISION

Sketch of Service Here

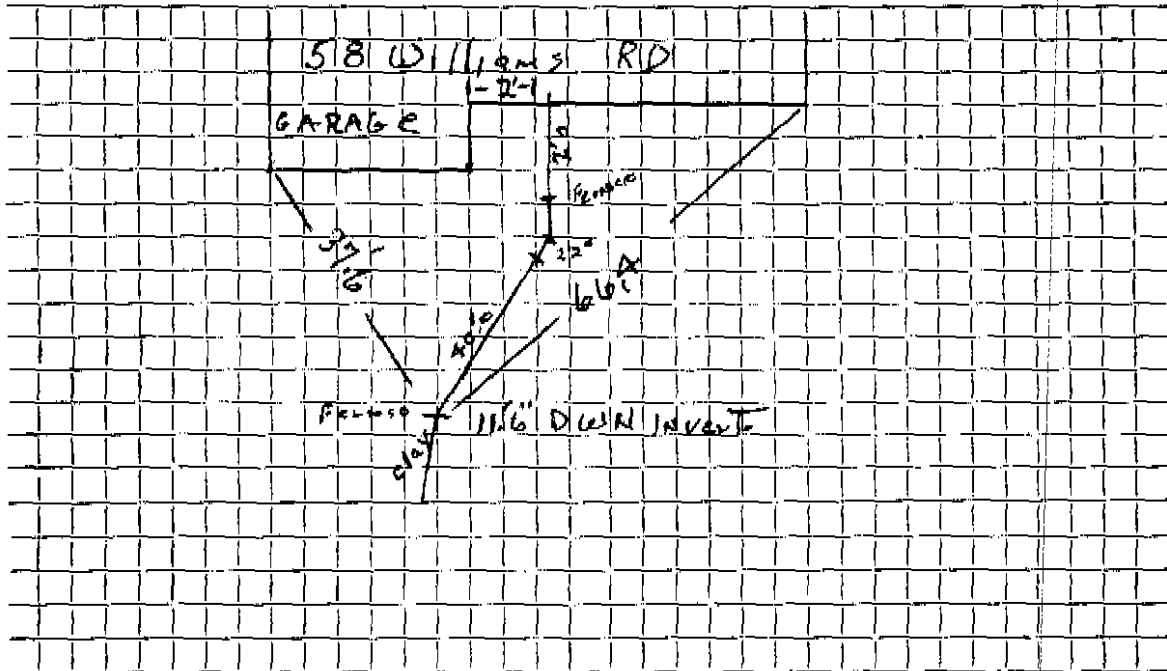

Connection made in Street.

Work completed 4/26/05 J. McLaughlin

Remarks:
.....
.....