

Name Angelo Martinelli **Barbara Coscia**

Service No. 13

Address 59 Williams Road

**59 Williams Road**

Location

Kind of Pipe

Size **6"**

Size of Main **8"**

~~Repair~~ **New Service**

*Conn. 5-3-54*

Location

Date	Material	Amount	Total	Date	Amount
3/22/54	Labor	20 42		3-8-54	Deposited 175 00
	10% overhead	2 04	22 46	5-4-54	*Refunded (43 34)
	40'-6" Sewer pipe @.3087		12 35	5-19-53	131 66
	Joint compound		2 40		18' 6" Sewer Pipe
	4-2/3 hr Littlefield shovel @ 7.50		35 00		1 6" Elbow
	1 hr trucking		75		
			72 96		
	Plus attached cash:		658 70		* \$6.15 made payable to Town
	total cost:		131 66		to apply on water conn. #39
10/29/98	Renewed - Inside				
	Labor				

TOWN OF LEXINGTON—DEPT. OF PUBLIC WORKS  
SEWER DIVISION

DATE.....

NO.....


The undersigned applies for the construction of a particular sewer connecting No.....  
Street and hereby agrees to comply with the Rules and Regulations governing the construction and use of Particular  
Sewers, as now or at any future time established by the Board of Selectmen.

Am't of estimate \$.....

Am't Paid \$.....

..... Owner

Sketch of Service Here

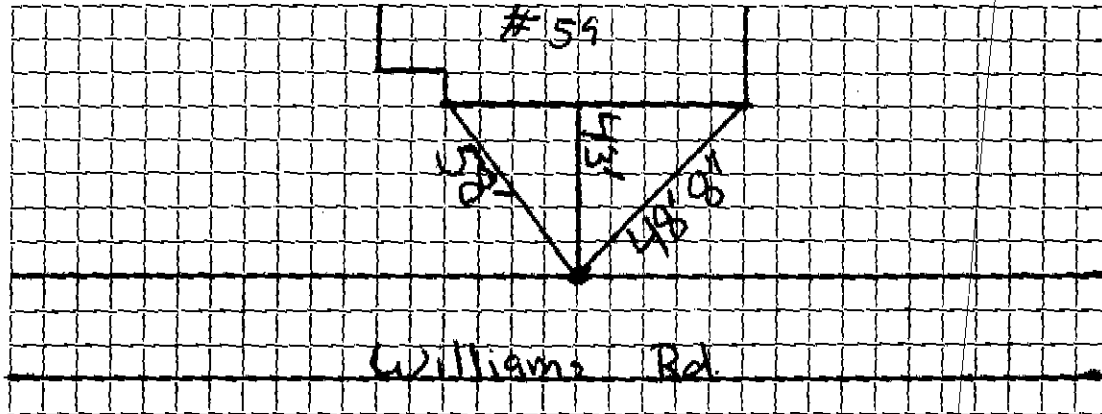

Connection made in..... Street.

Work completed.....19..

Remarks: