

Name Walter Ladow

Service No. 47

Address 65 Williams Road

Lexington *65 Williams Road* Location

Kind of Pipe

Size 6"

Size of Main 8"

~~WORK IN PROGRESS~~ - New Service

COM. 6-8-53

Location

Date	Material	Amount	Total	Date	Amount
4/21/53	Labor	62 33		3-25-53	Deposited 150 -
	10% overhead	6 23	68 56	6-8-53	Refunded (21 94)
	60' - 5" transite pipe @ .55		33 00		128 06
	5 hrs. town shovel @ 5.00		25 00		
	2 hrs. trucking @ .75		1 50		
			128 06		

Labor

TOWN OF LEXINGTON—DEPT. OF PUBLIC WORKS
SEWER DIVISION

DATE.....

NO.


The undersigned applies for the construction of a particular sewer connecting No.
Street and hereby agrees to comply with the Rules and Regulations governing the construction and use of Particular
Sewers, as now or at any future time established by the Board of Selectmen.

Am't of estimate \$.....

Am't Paid \$.....

..... Owner

Sketch of Service Here

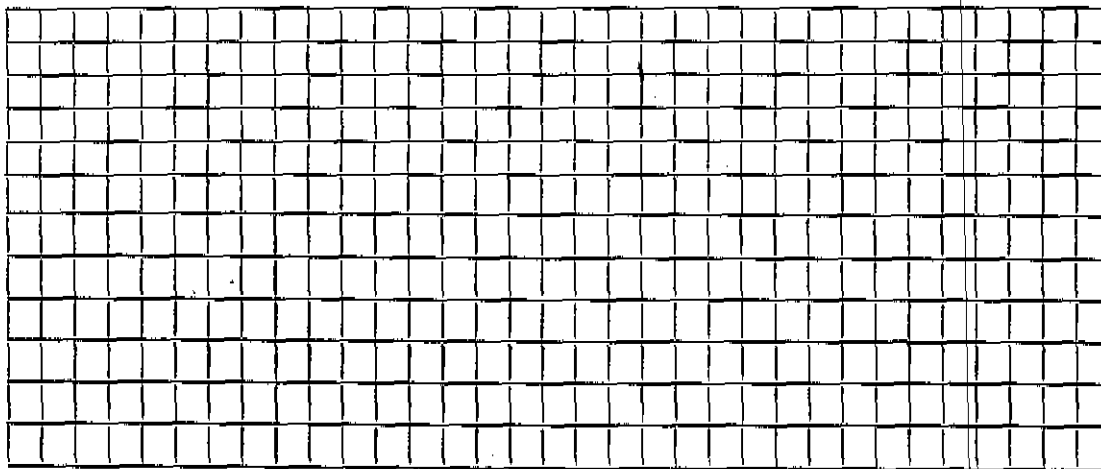

Connection made in..... Street.

Work completed.....19..

Remarks: