

Name Louis Stoico

Service No. 67

Address 16 Willow Street

Location

JUN 20 1977

Kind of Pipe

Size

Size of Main

Repair—Renewal—New Service

F.T.M. Construction #2989


Location

Date	Material	Amount	Total	Date	Amount
8/26/76	40' - 4" C.I.			8/17/76	400.00
8/19/76	labor	87.06		9-16-77	81.31
8/20/76	labor	145.10	232.16		481.31
	10% OH	23.22	255.38		
	5' X 6" transite pipe @ 1.56		9.15		
	tons pea stone @ 3.50		14.00		
	yds. gravel @ 2.19		21.90		
	12" X 8" cast iron saddle		15.09		
	30° elbow		4.75		
	4' X 6" nipple @ 2.97		11.88		
	20' length 4" water pipe @ 4.44		88.80		
	hrs. pick-up truck @ 1.50		3.00		
	hrs. shovel @ 6.50		26.00		
	hrs. trucking @ 3.00		9.00		
			481.31		

DATE _____

TOWN OF LEXINGTON — BOARD OF PUBLIC WORKS
SEWER DIVISION

Sketch of Service Here

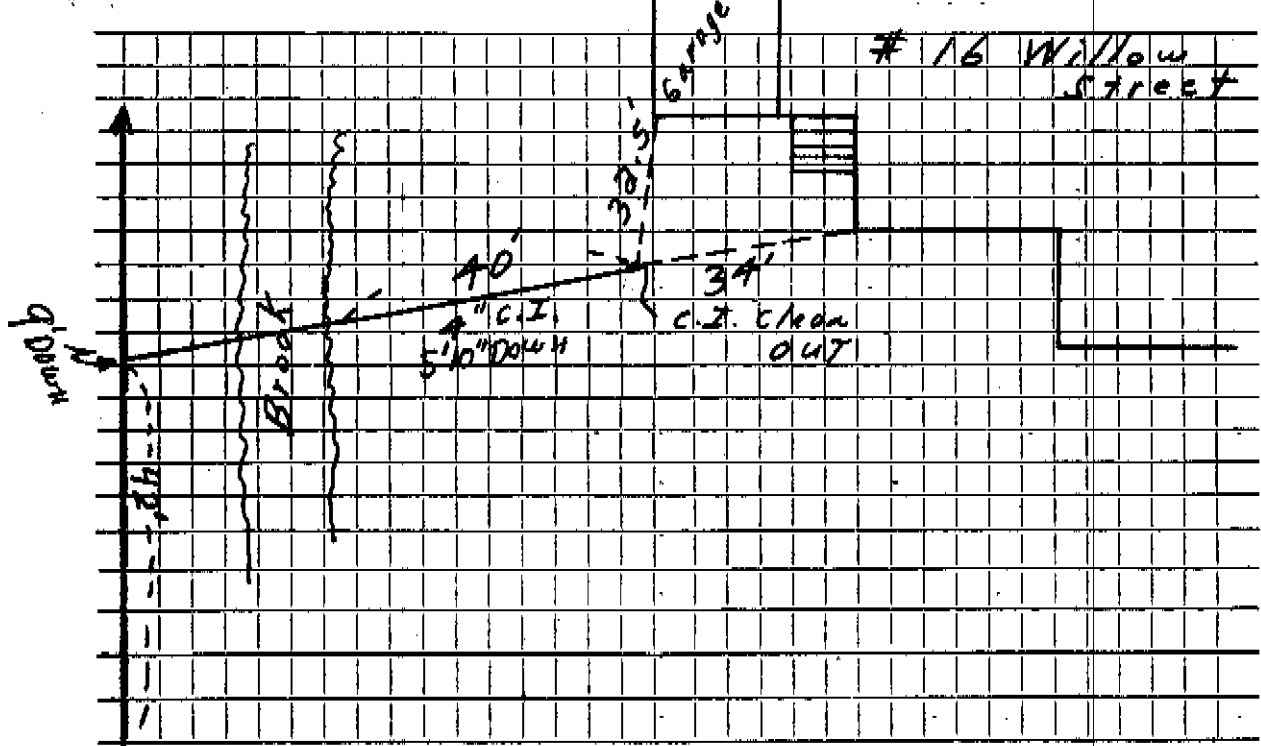

Connection made in _____ Street. Work completed _____

Remarks: _____

FORCED TRANSITE MAIN 9' DEEP

10' GRAVITY 9' DEEP

42'

14" FORCED STEEL MAIN

6" WARDEN MAIN


DROOK

8 1/2' DEEP

BRIDGE

5' 10" DEEP

10' TRANSITE 26' 4" WATER

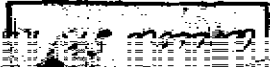

Handwritten notes and a small diagram at the bottom right corner.

5710

REG. NO. 603117

DATE 1-1-59

FEE

3

Whittaker Edward F Jr
58 Cliffe Ave
Lexington

Ford--1956 Conv Cpe 2d 5p

8

VEHICLE DESCRIPTION

NO. CYL. OR WGT.

M6CC131121

180053

VEHICLE IDENT. NO.

ENG. NO.

Lexington

Amer Pol

st

38.48

GARAGE

INS. CO.

600

COMMISSIONER'S VALUE

TAX LIST