


DATE 1/17/2020

TOWN OF LEXINGTON — BOARD OF PUBLIC WORKS
SEWER DIVISION

Sketch of Service Here

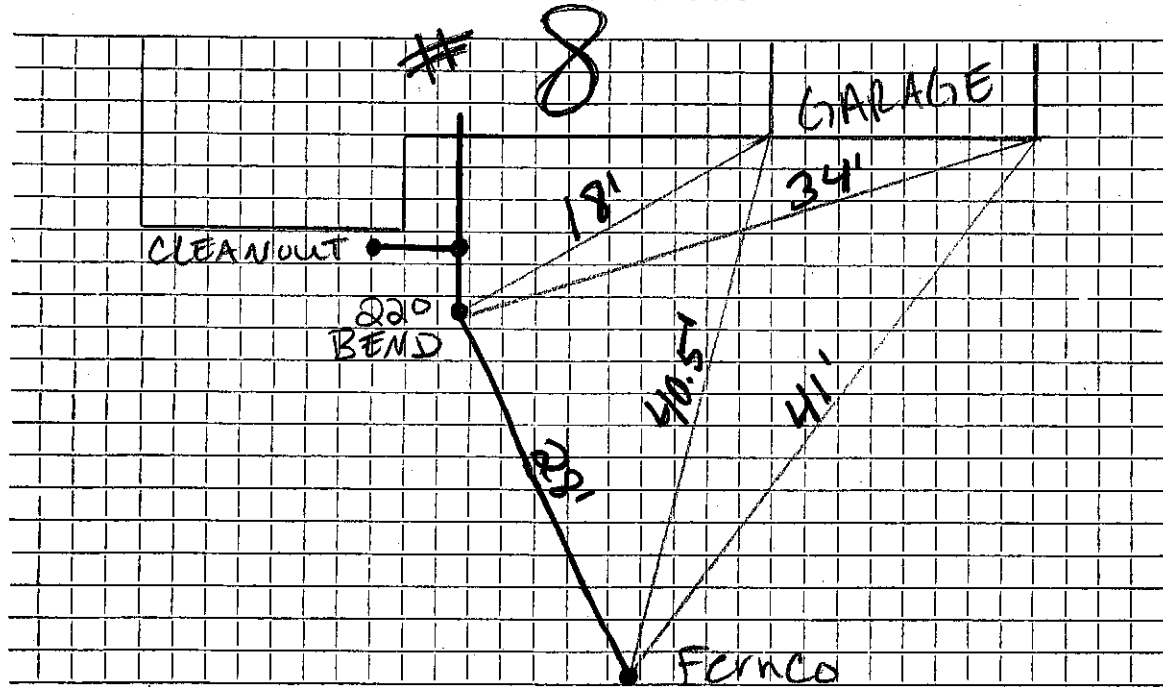

Connection made in Wilson Rd Street. Work completed

Remarks:
.....
.....