

Name Paul Penney

Service No. 177

Address 1 Wilson Road

1 Wilson Road

Location

Kind of Pipe

Size 6

Size of Main 8"

~~Repair~~ - New Service

Location *Comd 11-24-60*


Date	Material	Amount	Total	Date	Amount
9-19-60	Labor	92.96		9-19-60	1.50 00
9-21-60	"	9.96	102.92	11-2-60	43.51
	10% O.H.	10.29	113.21		193.51
	43' 6" Transite pipe @.78		33.54		
	1 6" Clay Elbow		1.88		
	12 x 3 Patch		12.00		
	5 1/2 ton 3/4" Stone		7.88		
	2 hrs. Town Shovel @6.50		13.00		
	3 hrs. Trucking @3.00		9.00		
	1 hr. Compressor @3.00		3.00		
			193.51		

*Bill* *Sum 193.51* *43.51*

DATE \_\_\_\_\_

TOWN OF LEXINGTON — BOARD OF PUBLIC WORKS  
SEWER DIVISION

Sketch of Service Here /

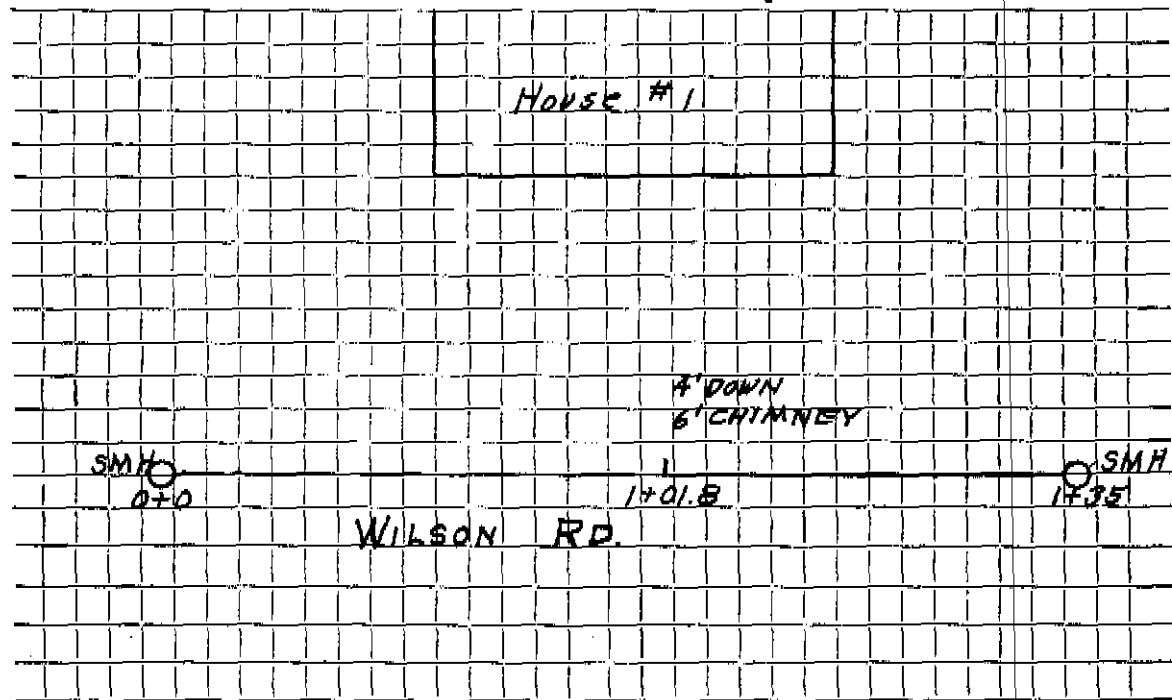

Connection made in ..... Street. Work completed .....

Remarks: .....

.....