

Name

Service No.

Address

11 Wilson RD

DEMO J McLaughlin

Location

Kind of Pipe

PVC

Size 6"

Size of Main

Repair

~~Renewal~~

New Service

Location

Date

Material

Amount

Total

Date

Amount

8-03

8'

4" Sch 40 PVC

69'

6" PVC

2

6" 22 1/2° bends

1

4x6 Fernco

1

6" ACX PVC Fernco


EXIST A.C.

DATE _____

TOWN OF LEXINGTON — BOARD OF PUBLIC WORKS

SEWER DIVISION

Sketch of Service Here

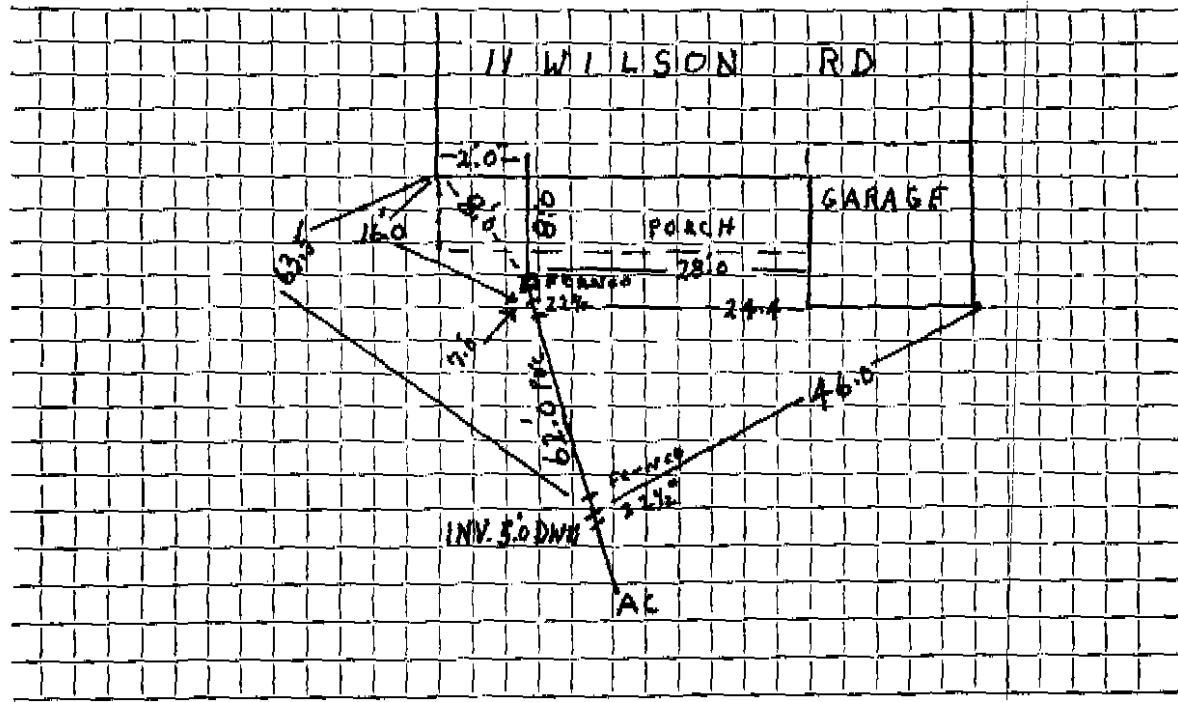

Connection made in Street. Work completed

Remarks: 7.0' BETWEEN FURROW AND 22 1/2" bend