

Name Lyman J. Cole

Service No. 203

Address 12 Wilson Road

12 Wilson Road

Location

Kind of Pipe

Size 6"

Size of Main 8"

~~REWORK~~ - New Service

Location *Com. 11-60*


Date	Material	Amount	Total	Date		Amount
10-28-60	Labor	83.54		10-5-60	Deposit	200.00
10-29-60	Labor	32.14		3-16-61	Paid	12.34
		115.68				212.34
	10% O.H.	11.57	127.25		NON CHARGE	
	461 6" Transite pipe @.78		35.88	10-29-60	Labor	16.06
	1 22 1/2" Transite Band		6.21	10-29-60	Labor	19.28
	6 hrs. Pippin Shovel @4.50		27.00	(Shovel Broke Down - Sat. Time)		
	2 hrs. Trucking @3.00		6.00			
	10 X 3 Patch		10.00			
			212.34			

Bill sent 12-10-60

DATE _____

TOWN OF LEXINGTON — BOARD OF PUBLIC WORKS
SEWER DIVISION

Sketch of Service Here **12**

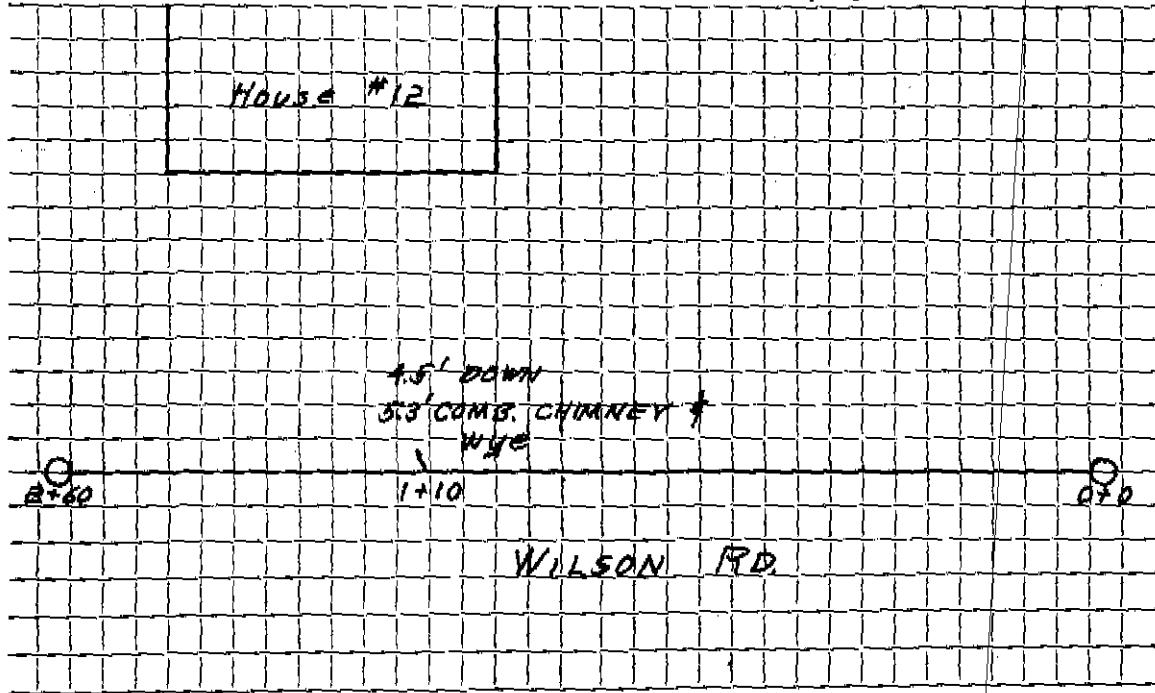

Connection made in Street. Work completed

Remarks:

.....

.....