

Name Richard W. Hawkins

Service No. 197

Address 14 Wilson Road

14 Wilson Road

Location

Kind of Pipe

Size 6"

Size of Main 8"


~~REPAIR~~ New Service Loc # 7737Location Cam ~~1-14-63~~

Date	Material	Amount	Total	Date	Amount
11-27-62	Labor	71.51		11-16-62	Deposit 225.00
	10% O.H.	7.15	78.66	1-14-63	R-Found 87.25
	50' 6" Transite pipe @.82		41.00		187.75
	1 90° Transite Elbow		4.09		
	4 hrs. Town Shovel @6.50		26.00		
	2 hrs. Trucking @3.00		6.00		
	12 x 3 Patch		12.00		
	Spring Loam & Seed		20.00		
	TEAR Down		187.75		
8/99	SEWER REPAIRED ENG. 1-14-63 DAN. V.				

DATE _____

TOWN OF LEXINGTON — BOARD OF PUBLIC WORKS
SEWER DIVISION

Sketch of Service Here **14**

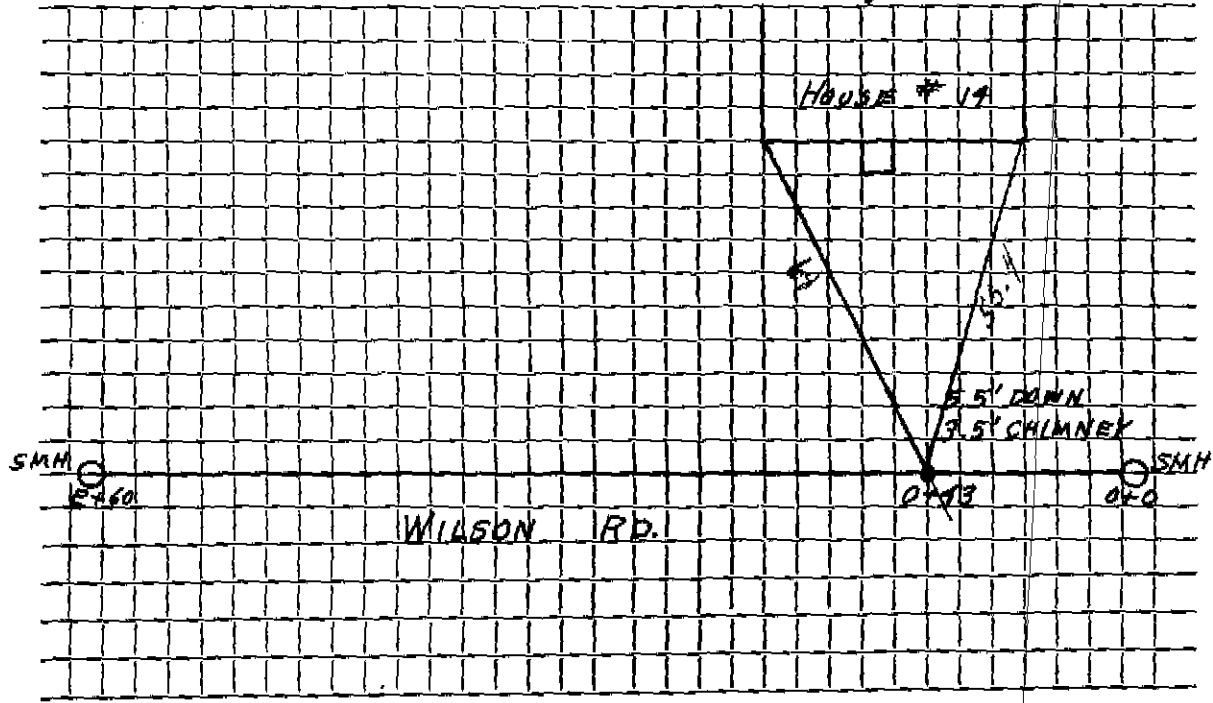

Connection made in Street. Work completed

Remarks: