


DATE 12-27-99

TOWN OF LEXINGTON — BOARD OF PUBLIC WORKS
SEWER DIVISION

Sketch of Service Here

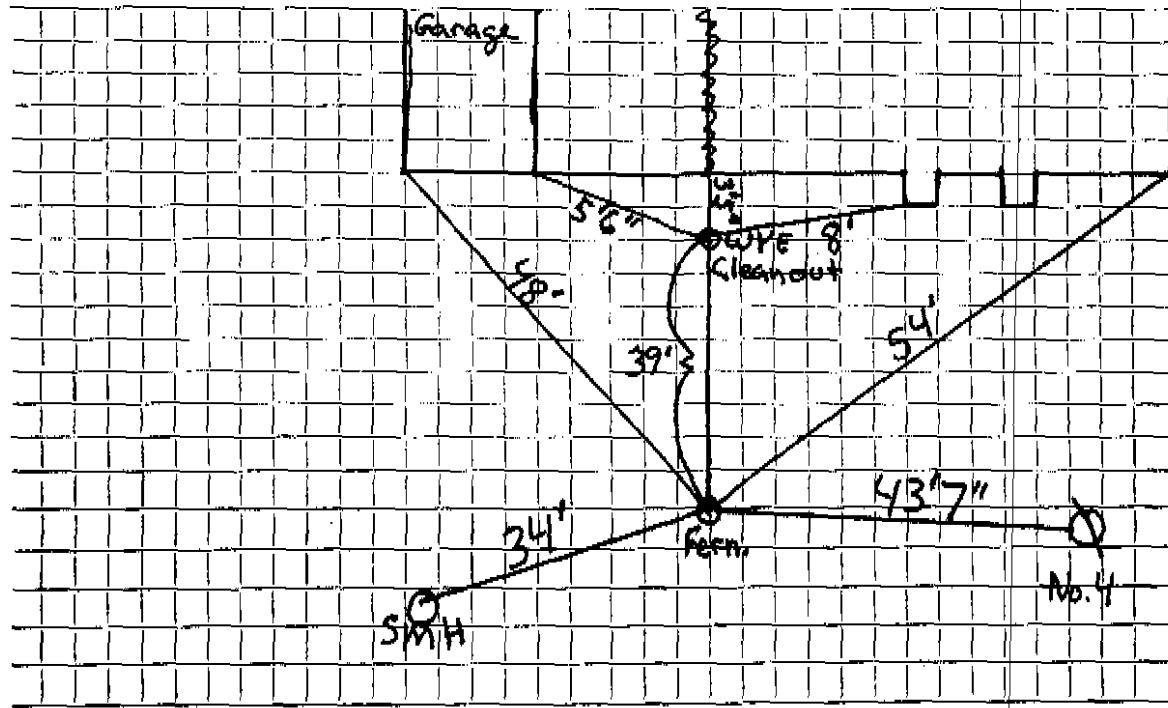

Connection made in Street. Work completed

Remarks:

Name Mary Croaby

Service No. 186

Address 15 Wilson Road

15 Wilson Road

Location

Kind of Pipe

Size 6"

Size of Main 8"

~~Repair~~ ~~Service~~ New Service

Location Conn 11-17-60


Date	Material	Amount	Total	Date	Amount
9-22-60	Labor	39.84		9-21-60	150.00
9-23-60	"	59.28	99.12	1960	48.75
	10% O.H.	9.91	109.03	5-24-60	3.86
	45' 6" Transite pipe @.78		35.10		202.61
	1 6" 22 ¹⁰ Transite Elbow		2.24		
	1 6" 11 ¹⁰ Transite Bend		5.10		
	1 6" 11 ¹⁰ Transite Elbow		2.24		
	1 6" 90° Transite Elbow		5.40		
	3 hrs. Town Shovel @6.50		19.50		
	1 hr. Compressor @3.00		3.00		
	3 hrs. Trucking @3.00		9.00		
	12 x 3 Patch		12.00		
			202.61		

1 1/2 3.00

DATE _____

TOWN OF LEXINGTON — BOARD OF PUBLIC WORKS
SEWER DIVISION

Sketch of Service Here **15**

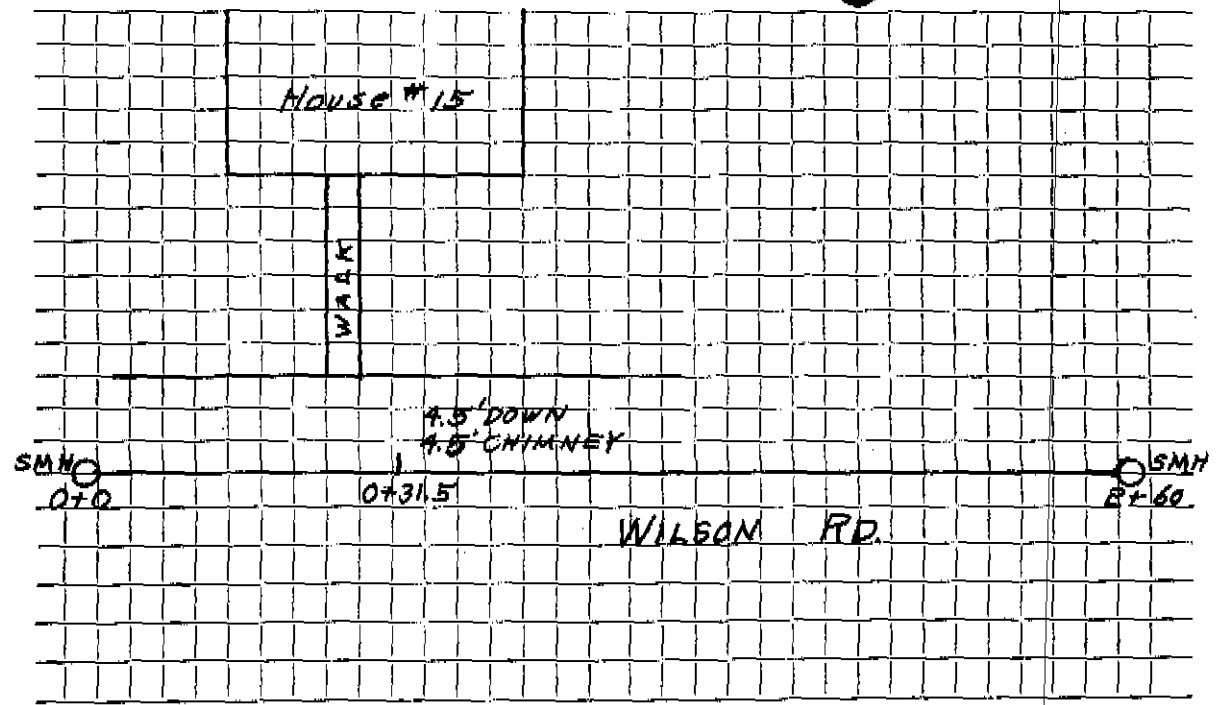

Connection made in Street. Work completed

Remarks:

.....