


DATE _____

TOWN OF LEXINGTON — BOARD OF PUBLIC WORKS

SEWER DIVISION

Sketch of Service Here

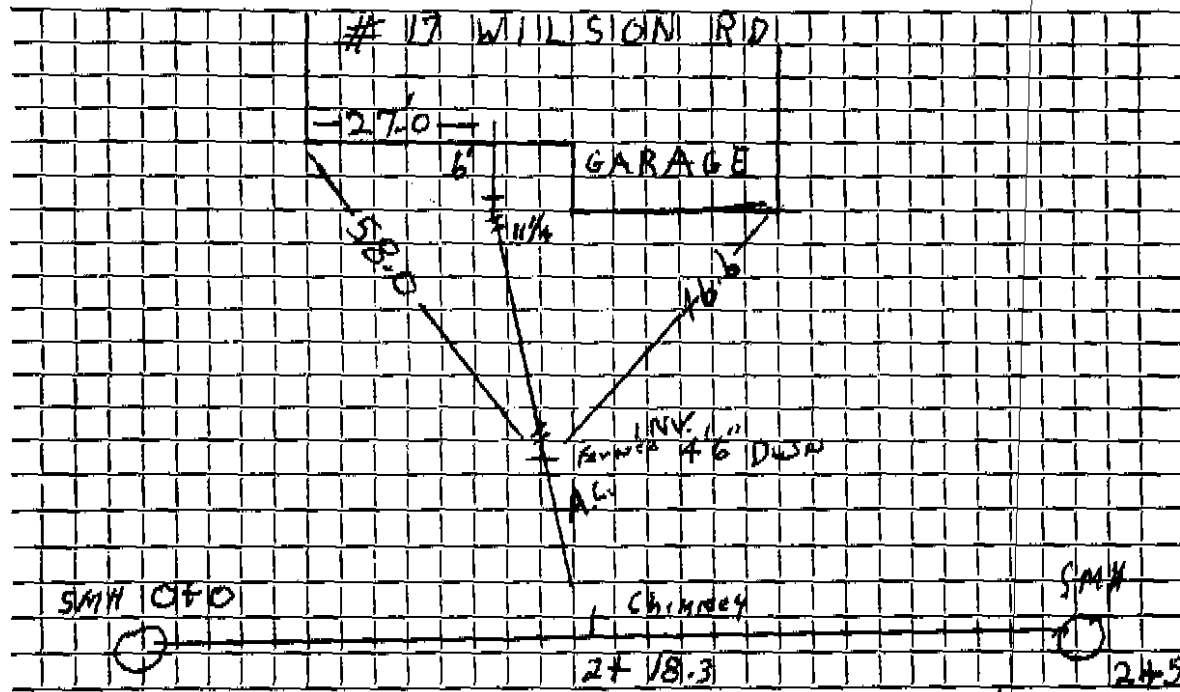

Connection made in Street. Work completed 12/5/06 J. McLaughlin.....

Remarks: 4"0 Cherry 4"5 Duck