

Name Adam Grigor

Service No. 13

Address 18 Wilson Road

18 Wilson Road

Location

Kind of Pipe

Size 6"

Size of Main 8"

~~Repair~~ Renewal - New Service

Location Comm 3-8-61


Date	Material	Amount	Total	Date	Amount
4-4-61	Labor	16.18		7-29-61	Deposit 125.00
4-5-61	"	32.36	48.54	5-8-61	Refund 43.22
	10% O.H.	4.85	53.39		131.23
	18' 6" Transite pipe @.78		37.44		
	1 6" 90° Transite Elbow		5.40		
	3 hrs. Pippin Shovel @5.00		15.00		
	3 hrs. Trucking @3.00		9.00		
	11 x 3 Patch		11.00		
			131.23		

TOWN OF LEXINGTON — BOARD OF PUBLIC WORKS  
SEWER DIVISION

DATE \_\_\_\_\_

Sketch of Service Here

18

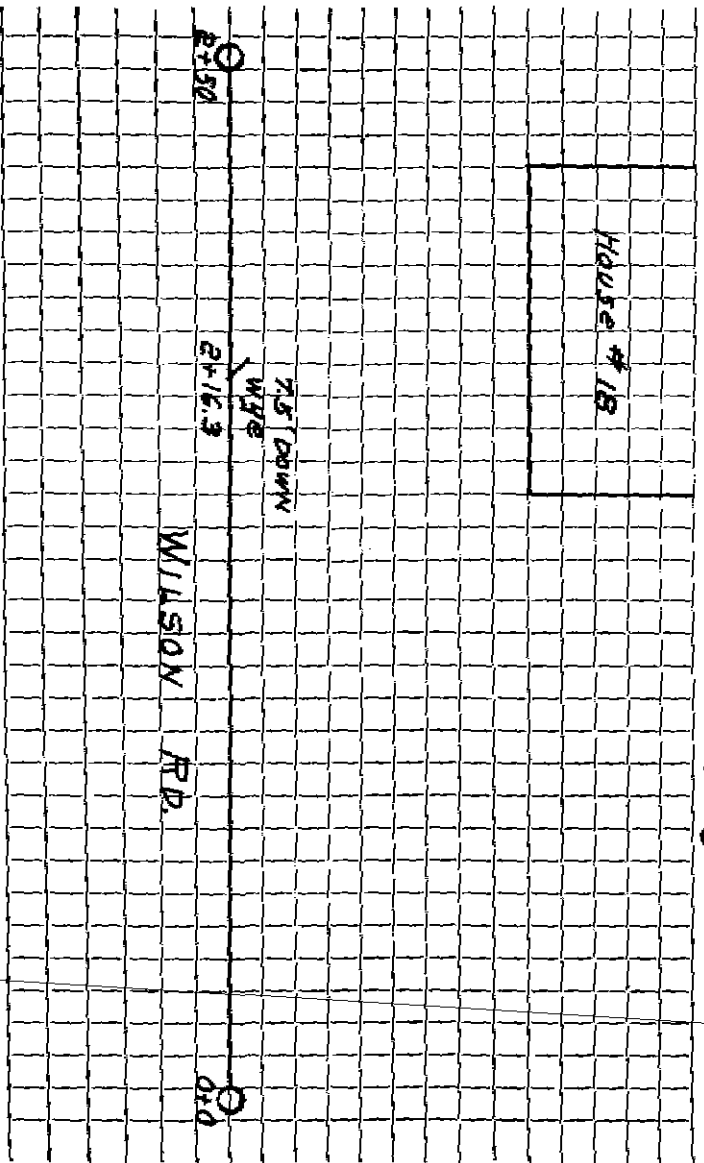

Connection made in ..... Street. Work completed .....

Remarks: .....