

Name Howard D. Ryder

Service No. 185

Address 2 Wilson Road

2 Wilson Road

Location

Kind of Pipe

Size 6"

Size of Main 8"


~~Repair~~ New Service Valeri #912 W.O. # 5986

Location AUG 5 1968

Date	Material	Amount	Total	Date	Amount
12/20/67	Labor	38 21		12-11-67	260 00
	Labor	10 41		8-30-68	5 58
	Labor	54 04			265 58
3/25/68	Labor	8 47			
	Labor	13 65			
	10% O.H.	12 49	137 37		
11'	6" transite pipe @ .88		9 68		
1	6" nipple		65		
1	90° elbow		4 09		
1	adaptor		2 76		
1/2	bag cement @ 1.55		78		
1	ton cold patch		5 50		
4 1/2	hrs. trucking @ 3.00		13 50		
2 1/2	hrs. shovel @ 6.50		16 25		
2	hrs. compressor		10 00		
1	hr. roller & trailer		5 00		
2 1/2	6" Transite Pipe				5.58

TOWN OF LEXINGTON — BOARD OF PUBLIC WORKS
SEWER DIVISION

Sketch of Service Here **2**

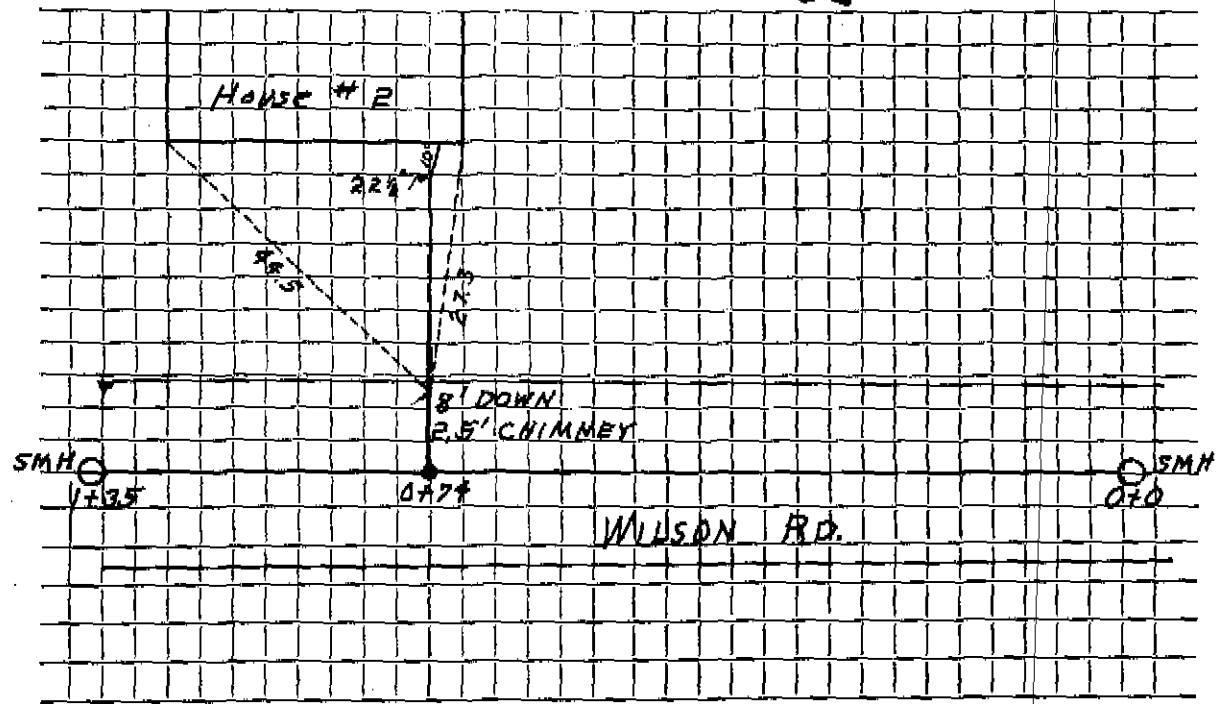

Connection made in Street. Work completed

Remarks:

.....

.....