

Name Paul Mazzarall

Service No. 266

Address 20 Wilson Road

20 Wilson Road

Location

Kind of Pipe

Size 6"

Size of Main 8"

~~Renewal~~ New Service

Location *Cam 12-31-60*

Date	Material	Amount	Total	Date	Amount
11-25-60	Labor	68.20		11-25-60	Deposit
11-26-60	"	7.87	76.07	1-13-60	Paid
	10% O.H.	7.61	83.68		
	20' 6" Transite pipe @.78		31.20		NON CHARGE
	12 x 3 Patch		12.00	11-26-60	Labor
	2 hrs. Town Shovel @ 6.50		13.00		7.87
	2 hrs. Trucking @3.00		6.00		
			145.88		


Bill sent 12-31-60

DATE _____

TOWN OF LEXINGTON -- BOARD OF PUBLIC WORKS
SEWER DIVISION

Sketch of Service Here

20

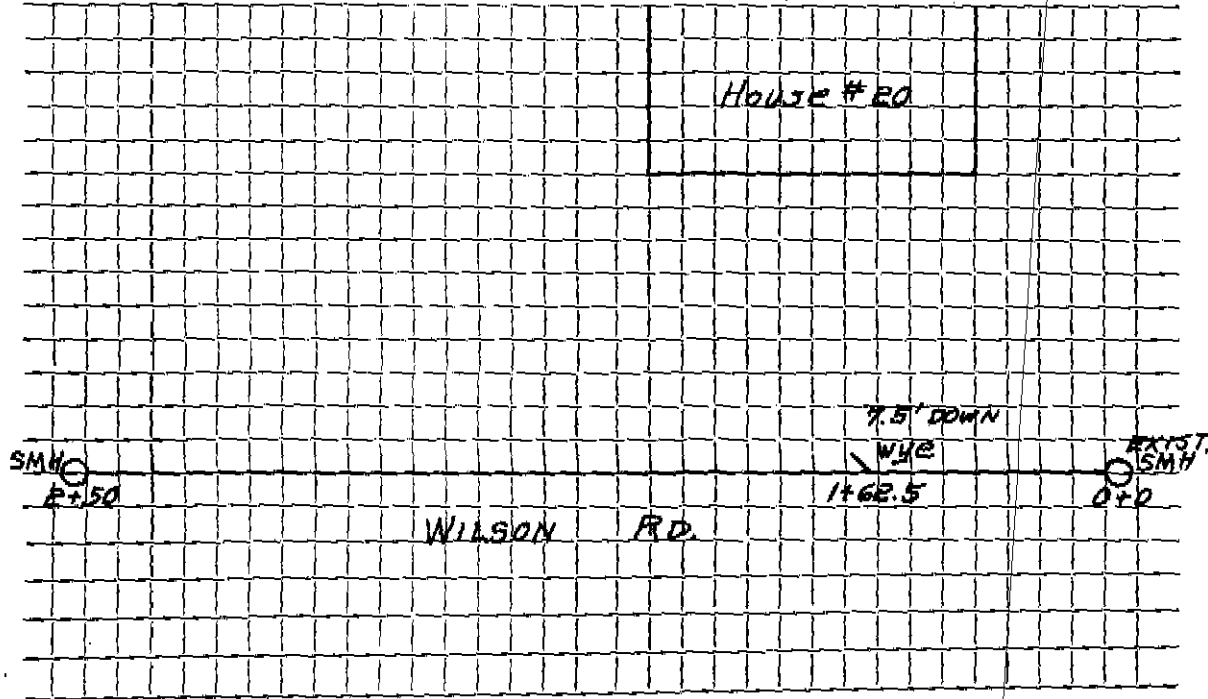

Connection made in Street. Work completed

Remarks:

.....

.....